



---

**west virginia** department of environmental protection

---

Office of Oil and Gas  
601 57th Street SE  
Charleston, WV 25304  
(304) 926-0450  
(304) 926-0452 fax

Earl Ray Tomblin, Governor  
Randy C. Huffman, Cabinet Secretary  
www.dep.wv.gov

December 03, 2015

**WELL REGISTER PERMIT**  
**Assigned Permit Number**

This API Well Number: 47-10303146, issued to ASCENT RESOURCES-MARCELLUS, LLC, is evidence of permission to operate the well that is referenced at the location described on the attached plat, subject to the provisions of Chapters 22 and 22B of the West Virginia Code of 1931, as amended, and all rules and regulations promulgated thereunder. Spills or emergency discharges must be reported to 1-800-642-3074.

Failure to abide by the statutory and regulatory provisions governing all duties and operations hereunder may result in suspensions or revocation of your permits and in addition may result in civil and/or criminal penalties.

Annual production reports must be submitted on this well and failure to do so may require you to plug the well.



James Martin  
Chief

Operator's Well No: 15  
Farm Name: WV Division of Natural Resources  
**API Well Number: 47-10303146**  
**Permit Type: Assigned Permit Number**  
Date Issued: 12/03/2015

Promoting a healthy environment.

12/04/2015



West Virginia Department of Environmental Protection  
Office of Oil and Gas  
**WELL LOCATION FORM: GPS**

API: 47-103-03146 WELL NO.: 15

FARM NAME: Fluharty William

RESPONSIBLE PARTY NAME: Ascent Resources - Marcellus, LLC

COUNTY: Wetzel DISTRICT: Green

QUADRANGLE: Center Point

SURFACE OWNER: WV Division of Natural Resources

ROYALTY OWNER: \_\_\_\_\_

UTM GPS NORTHING: 4369854.8

UTM GPS EASTING: 525797.6 GPS ELEVATION: 1015'

The Responsible Party named above has chosen to submit GPS coordinates in lieu of preparing a new well location plat for a plugging permit or assigned API number on the above well. The Office of Oil and Gas will not accept GPS coordinates that do not meet the following requirements:

1. Datum: NAD 1983, Zone: 17 North, Coordinate Units: meters, Altitude: height above mean sea level (MSL) – meters.
2. Accuracy to Datum – 3.05 meters
3. Data Collection Method:

Survey grade GPS \_\_\_\_\_: Post Processed Differential \_\_\_\_\_

Real-Time Differential \_\_\_\_\_


Mapping Grade GPS X: Post Processed Differential \_\_\_\_\_

Real-Time Differential X \_\_\_\_\_

RECEIVED  
Office of Oil and Gas  
DEC 01 2015

4. **Letter size copy of the topography map showing the well location.**  
I the undersigned, hereby certify this data is correct to the best of my knowledge and belief and shows all the information required by law and the regulations issued and prescribed by the Office of Oil and Gas.

[Signature] Regulatory Technician 11/30/2015  
Signature Title Date

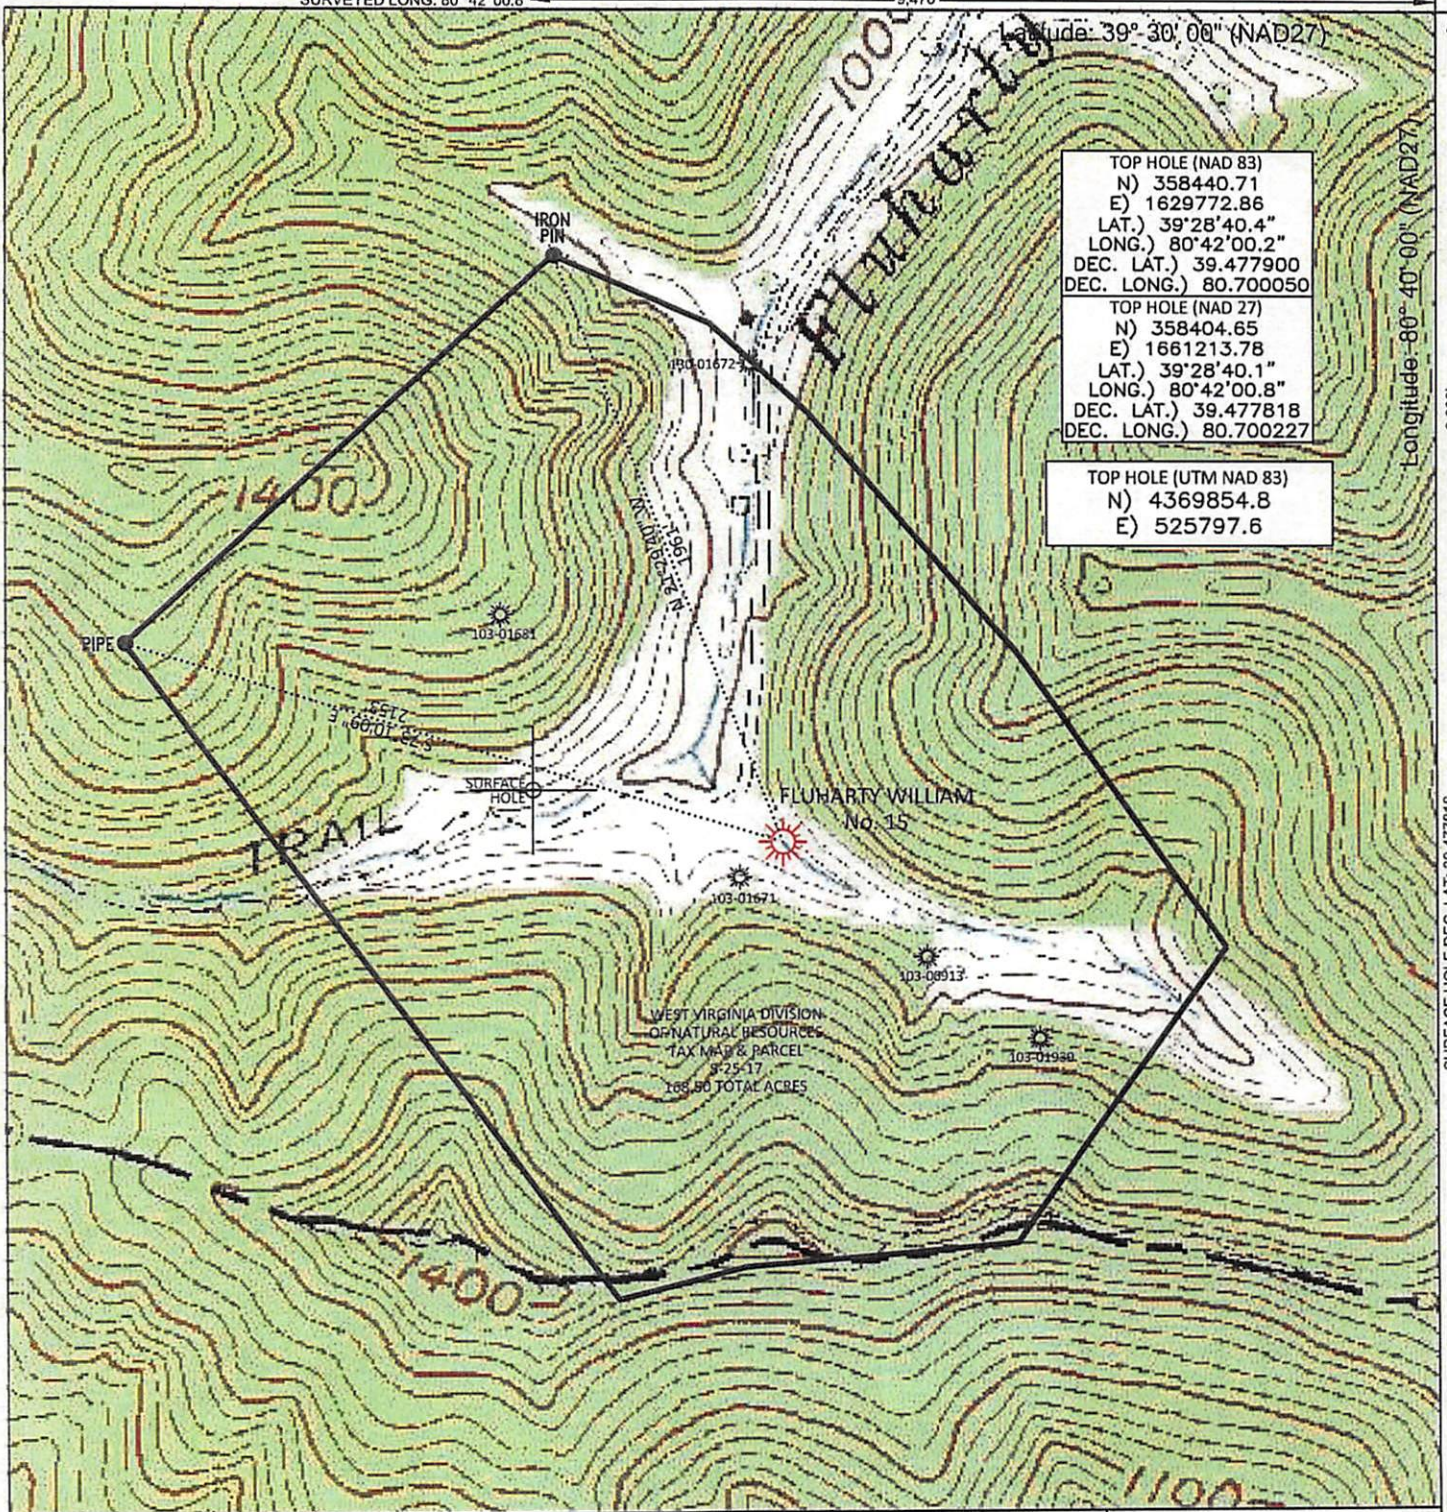

TOP HOLE (NAD 83)  
 N) 358440.71  
 E) 1629772.86  
 LAT.) 39°28'40.4"  
 LONG.) 80°42'00.2"  
 DEC. LAT.) 39.477900  
 DEC. LONG.) 80.700050


TOP HOLE (NAD 27)  
 N) 358404.65  
 E) 1661213.78  
 LAT.) 39°28'40.1"  
 LONG.) 80°42'00.8"  
 DEC. LAT.) 39.477818  
 DEC. LONG.) 80.700227

TOP HOLE (UTM NAD 83)  
 N) 4369854.8  
 E) 525797.6

FILE #: AE003  
 DRAWING #: 2651  
 SCALE: PLAT - 1" = 600'  
 TICK MARK - 1" = 2000'  
 MINIMUM DEGREE OF ACCURACY: 1/200  
 PROVEN SOURCE OF ELEVATION: SUBMETER MAPPING GRADE GPS

I, THE UNDERSIGNED, HEREBY CERTIFY THAT THIS PLAT IS CORRECT TO THE BEST OF MY KNOWLEDGE AND BELIEF AND SHOWS ALL THE INFORMATION REQUIRED BY LAW AND THE REGULATIONS ISSUED AND PRESCRIBED BY THE DEPARTMENT OF ENVIRONMENTAL PROTECTION.

Signed: *[Signature]*  
 L.L.S. #2124 : Ernest J. Benchek III

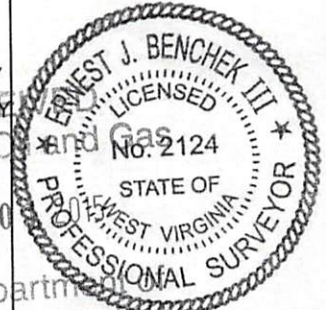

DEC 20 2015  
 WV Department of Environmental Protection

(+) DENOTES LOCATION OF WELL ON UNITED STATES TOPOGRAPHIC MAPS WYDEP  
 OFFICE OF OIL & GAS  
 601 57TH STREET  
 CHARLESTON, WV 25304

Well Type:  Oil  Waste Diposal  Production  Deep  
 Gas  Liquid Injection  Storage  Shallow

WATERSHED: FISHING CREEK  
 COUNTY/DISTRICT: WETZEL / GREEN  
 SURFACE OWNER: WEST VIRGINIA DIVISION OF NATURAL RESOURCES  
 OIL & GAS ROYALTY OWNER:  
 LEASE NUMBERS:

DATE: NOVEMBER 20, 2015  
 OPERATOR'S WELL #: FLUHARTY WILLIAM No. 15  
 API WELL #: 47 103 03146N  
 STATE COUNTY PERMIT

ELEVATION: 1015'  
 QUADRANGLE: CENTER POINT, WV  
 ACREAGE: 168.50 +/-  
 ACREAGE: 168.50 +/-

DRILL  CONVERT  DRILL DEEPER  REDRILL  FRACTURE OR STIMULATE   
 PLUG OFF FORMATION  PERFORATE NEW FORMATION  PLUG & ABANDON   
 CLEAN OUT & REPLUG  OTHER CHANGE  (SPECIFY):

WELL OPERATOR: Ascent Resources-Marcellus LLC. ADDRESS: 3501 NW 63rd Street CITY: Oklahoma City STATE: OK ZIP CODE: 73116  
 DESIGNATED AGENT: Eric B. Gillespie ADDRESS: 103 Taryn Lane CITY: Cross Lanes STATE: WV ZIP CODE: 25313

12/04/2015



November 13, 2015

West Virginia Department of Environmental Protection  
Office of Oil and Gas  
Attn: Justin Nottingham or whomever concerned  
601 57<sup>th</sup> Street  
Charleston, West Virginia 25304

Re: Well Transfer forms

Dear Mr. Nottingham,

Ascent Energy – Marcellus, LLC respectfully submits the following WW-7 Well Location Form: GPS to assign API numbers to two wells; Fluharty William 15 and LeMasters Jasper 21. Included with the WW-7 forms is also a topographic map showing each wells location. Once these wells are assigned an API number, please feel free to notify me via email.

If you need any additional information, please feel free to contact me.

Best Regards,

A handwritten signature in black ink, appearing to read 'Ariel Bravo', followed by a long horizontal line.

Ariel Bravo  
Regulatory Technician  
[ariel.bravo@ascentresources.com](mailto:ariel.bravo@ascentresources.com)  
Cell 405-403-4803  
Office 405-607-5529

RECEIVED  
Office of Oil and Gas  
DEC 01 2015  
WV Department of  
Environmental Protection