



WELL BORE TABLE FOR SURFACE / ROYALTY OWNERS		
TRACT	SURFACE OWNER (S) / ROYALTY OWNER (R)	TAX PARCEL
1	SWN PRODUCTION COMPANY, LLC (S) RODNEY CALVERT, ET AL (R)	12-10-29
TRACT	SURFACE OWNER	TAX PARCEL
2	RODNEY A. CALVERT	12-10-29.5
3	GARY G. YOCUM & LAVERNE F. YOCUM (LIFE ESTATE); CHRIS B. YOCUM (REMAINDERMAN)	12-15-9
4	SWN PRODUCTION COMPANY, LLC	12-10-28
5	DARREN YOHO; KEVIN YOHO; BRADLEY YOHO; JEFFREY YOHO; DEBORAH YOHO	12-10-16
6	SWN PRODUCTION COMPANY, LLC	12-10-15
7	SWN PRODUCTION COMPANY, LLC	12-10-10
8	ROBERT A. STOUT & SHERI L. STOUT, HUSBAND AND WIFE, AND UNTO SURVIVOR OF THEM	12-10-9
9	MILLTREE PROPERTIES, LLC	12-10-2
10	MILLTREE PROPERTIES, LLC	12-10-1.1
11	ANDREW D. SHULUGA & ANDREA M. SHULUGA, HUSBAND AND WIFE, AND UNTO SURVIVOR OF THEM	12-10-1
12	MARK MASSARI	12-4-38
13	CHRISTOPHER P. BITHELL	12-4-26

ADJOINING OWNERS TABLE		
TRACT	SURFACE OWNER	TAX PARCEL
A	JOSEPH C. DREYER	12-15-8
B	RODNEY A. CALVERT	12-10-29.3
C	RODNEY A. CALVERT	12-10-29.4
D	RODNEY CALVERT & ET AL	12-10-29.1
E	HAESSLY LAND & TIMBER, LLC, AN OHIO LIMITED LIABILITY COMPANY	12-10-33
F	HAESSLY LAND & TIMBER, LLC	12-10-32
G	SWN PRODUCTION COMPANY, LLC	12-10-27
H	ROBERT C. RITCHEA & JAMES L. RITCHEA	12-10-22
I	SWN PRODUCTION COMPANY, LLC	12-10-14
J	COURTNEY E. RICHMOND & RHEA K. RICHMOND, HIS WIFE	12-10-21
K	COURTNEY E. RICHMOND & RHEA K. RICHMOND, HIS WIFE	12-10-13
L	ANDREW D. SHULUGA & ANDREA M. SHULUGA, CO-TRUSTEES OF THE ANDREW D. SHULUGA AND ANDREA M. SHULUGA REVOCABLE TRUST	12-9-15
M	ANDREW D. SHULUGA & ANDREA M. SHULUGA, CO-TRUSTEES OF THE ANDREW D. SHULUGA AND ANDREA M. SHULUGA REVOCABLE TRUST	12-9-9
N	ANDREW D. SHULUGA & ANDREA M. SHULUGA, CO-TRUSTEES OF THE ANDREW D. SHULUGA AND ANDREA M. SHULUGA REVOCABLE TRUST	12-9-8
O	CHRISTOPHER P. BITHELL	12-4-37
P	WILLIAM WAGNER & BARBARA WAGNER (LIFE ESTATE); ROBERTA BROOKS AND HEATHER BRINK (REMAINDERMAN)	12-4-36
Q	CHRISTOPHER P. BITHELL	12-4-35
R	JOHN H. MORGAN & SUE M. MORGAN, TRUSTEES, U/T/A DATED JUNE 10, 1992 F/B/O THE MORGAN FAMILY	12-4-34
S	SHIBEN ESTATES	12-4-25
T	NANCY RABER & ET AL	12-4-16
U	CHRISTOPHER P. BITHELL	12-4-17
V	NANCY RABER & ET AL	12-4-6
W	NANCY RABER & ET AL	12-4-7
X	JOHN STULGA	12-4-19
Y	SCHOOL LOT	12-4-18
Z	CLAUDIA MECKEL-JONAS; ROBERT MECKEL; AND ASTRID MECKEL-HAUPT, AS JOINT TENANTS WITH RIGHT OF SURVIVORSHIP	12-4-27
AA	JAMES L. RITCHEA & HAZEL JORETTA RITCHEA	12-4-39
AB	RICHARD W. MASTNEY & MARK MASSARI	12-5-29
AC	RICHARD W. MASTNEY & MARK MASSARI	12-5-20
AD	ROBERT A. STOUT & SHERI L. STOUT, HUSBAND AND WIFE, AND UNTO SURVIVOR OF THEM	12-10-3
AE	SWN PRODUCTION COMPANY, LLC	12-10-11
AF	BRADLEY SCOTT YOHO	12-10-19
AG	DARREN YOHO; KEVIN YOHO; BRADLEY YOHO; JEFFREY YOHO; DEBORAH YOHO	12-10-17
AH	DARREN YOHO; KEVIN YOHO; BRADLEY YOHO; JEFFREY YOHO; DEBORAH YOHO	12-10-18
AI	CORY & DAVID DURIG	01-7-2
AJ	NORMA F. YOHO	01-7-40
AK	JACOB BICKERSTAFF & ANNA BICKERSTAFF, HUSBAND AND WIFE	12-10-29.2
AL	ERIC L. YEATER & AMANDA J. YEATER, HUSBAND AND WIFE	12-10-34
AM	HAESSLY LAND & TIMBER, LLC, AN OHIO LIMITED LIABILITY COMPANY	12-15-11
AN	HAESSLY LAND & TIMBER, LLC, AN OHIO LIMITED LIABILITY COMPANY	12-15-10
AO	JEFFREY J. YOHO	12-10-16.1
AP	ANDREW D. SHULUGA & ANDREA M. SHULUGA, CO-TRUSTEES OF THE ANDREW D. SHULUGA AND ANDREA M. SHULUGA REVOCABLE TRUST	12-10-9.1

REVISIONS:

COMPANY:

**SWN**  
Production Company, LLC

**SWN** <sup>R<sup>2</sup>-V<sup>+</sup></sup><sub>A</sub>  
Production Company™

OPERATOR'S

SWN A

DATE: 05-04-2020

WELL #:

WTZ 5H

DRAWN BY: R. GRIMES

DISTRICT:  
PROCTOR


COUNTY:  
WETZEL

STATE:  
WV

SCALE: N/A  
DRAWING NO: 2016-519  
WELL LOCATION PLAT



<b>SURFACE HOLE LOCATION (SHL):</b>
GEOGRAPHIC (NAD83):
LATITUDE: 39.682614°
LONGITUDE: -80.639608°
<b>BOTTOM HOLE LOCATION (BHL):</b>
GEOGRAPHIC (NAD83):
LATITUDE: 39.707907°
LONGITUDE: -80.674283°
<b>SURFACE HOLE LOCATION (SHL):</b>
GEOGRAPHIC (NAD83):
LATITUDE: 39.682614°
LONGITUDE: -80.639608°
<b>BOTTOM HOLE LOCATION (BHL):</b>
GEOGRAPHIC (NAD83):
LATITUDE: 39.707905°
LONGITUDE: -80.674296°

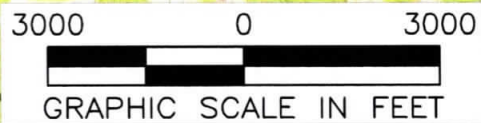

**NOTES ON SURVEY**

1. SURFACE AND ROYALTY OWNER INFORMATION AND THEIR BOUNDARIES SHOWN HEREON WERE PLOTTED FROM DEEDS AND/OR TAX PARCEL MAPS PROVIDED BY CLIENT AND/OR FIELD LOCATIONS.
2. THIS PLAT DOES NOT REPRESENT A BOUNDARY SURVEY OF THE PARCELS SHOWN HEREON.
3. ALL INSETS ARE GRID NORTH UNLESS OTHERWISE DEPICTED.

**LEGEND:**

- EXISTING BOTTOM HOLE
- EXISTING / PRODUCING WELLHEAD
- EXISTING LANDING POINT LOCATION
- PROPOSED SURFACE HOLE / BOTTOM HOLE
- PROPOSED LANDING POINT LOCATION
- ACCESS ROAD
- PUBLIC ROAD
- FLOOD PLAIN
- LEASE BOUNDARY
- AS-DRILLED PATH
- PROPOSED PATH

<b>WELL OPERATOR:</b> SWN PRODUCTION COMPANY, LLC	<b>WELL (FARM) NAME:</b> SWN A WTZ	<b>WELL #</b> 5H	<b>SERIAL #</b> XXXX
<b>ADDRESS:</b> 1300 FORT PIERPONT DRIVE, SUITE 201, MORGANTOWN WV, 26508	<b>COUNTY - CODE</b> WETZEL 103 -	<b>DISTRICT; PROCTOR</b>	<b>API #</b> 47-103-03233
<b>SURFACE OWNER:</b> SWN PRODUCTION COMPANY, LLC	<b>USGS 7 1/2 QUADRANGLE MAP NAME</b> WILEYVILLE, WV		