

WW-7
8-30-06



West Virginia Department of Environmental Protection
Office of Oil and Gas
WELL LOCATION FORM: GPS

API: 47-103-72441 WELL NO.: 7259
 FARM NAME: I. D. MORGAN
 RESPONSIBLE PARTY NAME: WEST VIRGINIA LAND RESOURCES INC.
 COUNTY: WETZEL DISTRICT: GRANT
 QUADRANGLE: BIG RUN W.VA
 SURFACE OWNER: SOUTHERN COUNTRY FARMS INC.
 ROYALTY OWNER: _____
 UTM GPS NORTHING: 4,373,021 m (918')
 UTM GPS EASTING: 539,832 m GPS ELEVATION: 280 m

The Responsible Party named above has chosen to submit GPS coordinates in lieu of preparing a new well location plat for a plugging permit or assigned API number on the above well. The Office of Oil and Gas will not accept GPS coordinates that do not meet the following requirements:

1. Datum: NAD 1983, Zone: 17 North, Coordinate Units: meters, Altitude: height above mean sea level (MSL) – meters.
2. Accuracy to Datum – 3.05 meters
3. Data Collection Method:

Survey grade GPS _____: Post Processed Differential _____

Real-Time Differential _____

Mapping Grade GPS : Post Processed Differential

Real-Time Differential _____

4. **Letter size copy of the topography map showing the well location.**

I the undersigned, hereby certify this data is correct to the best of my knowledge and belief and shows all the information required by law and the regulations issued and prescribed by the Office of Oil and Gas.

Signature

Professional Surveyor

Title

APRIL 21, 2021

Date


RECEIVED
Office of Oil and Gas

APR 29 2021

WV Department of
Environmental Protection

05/07/2021

4710303401P

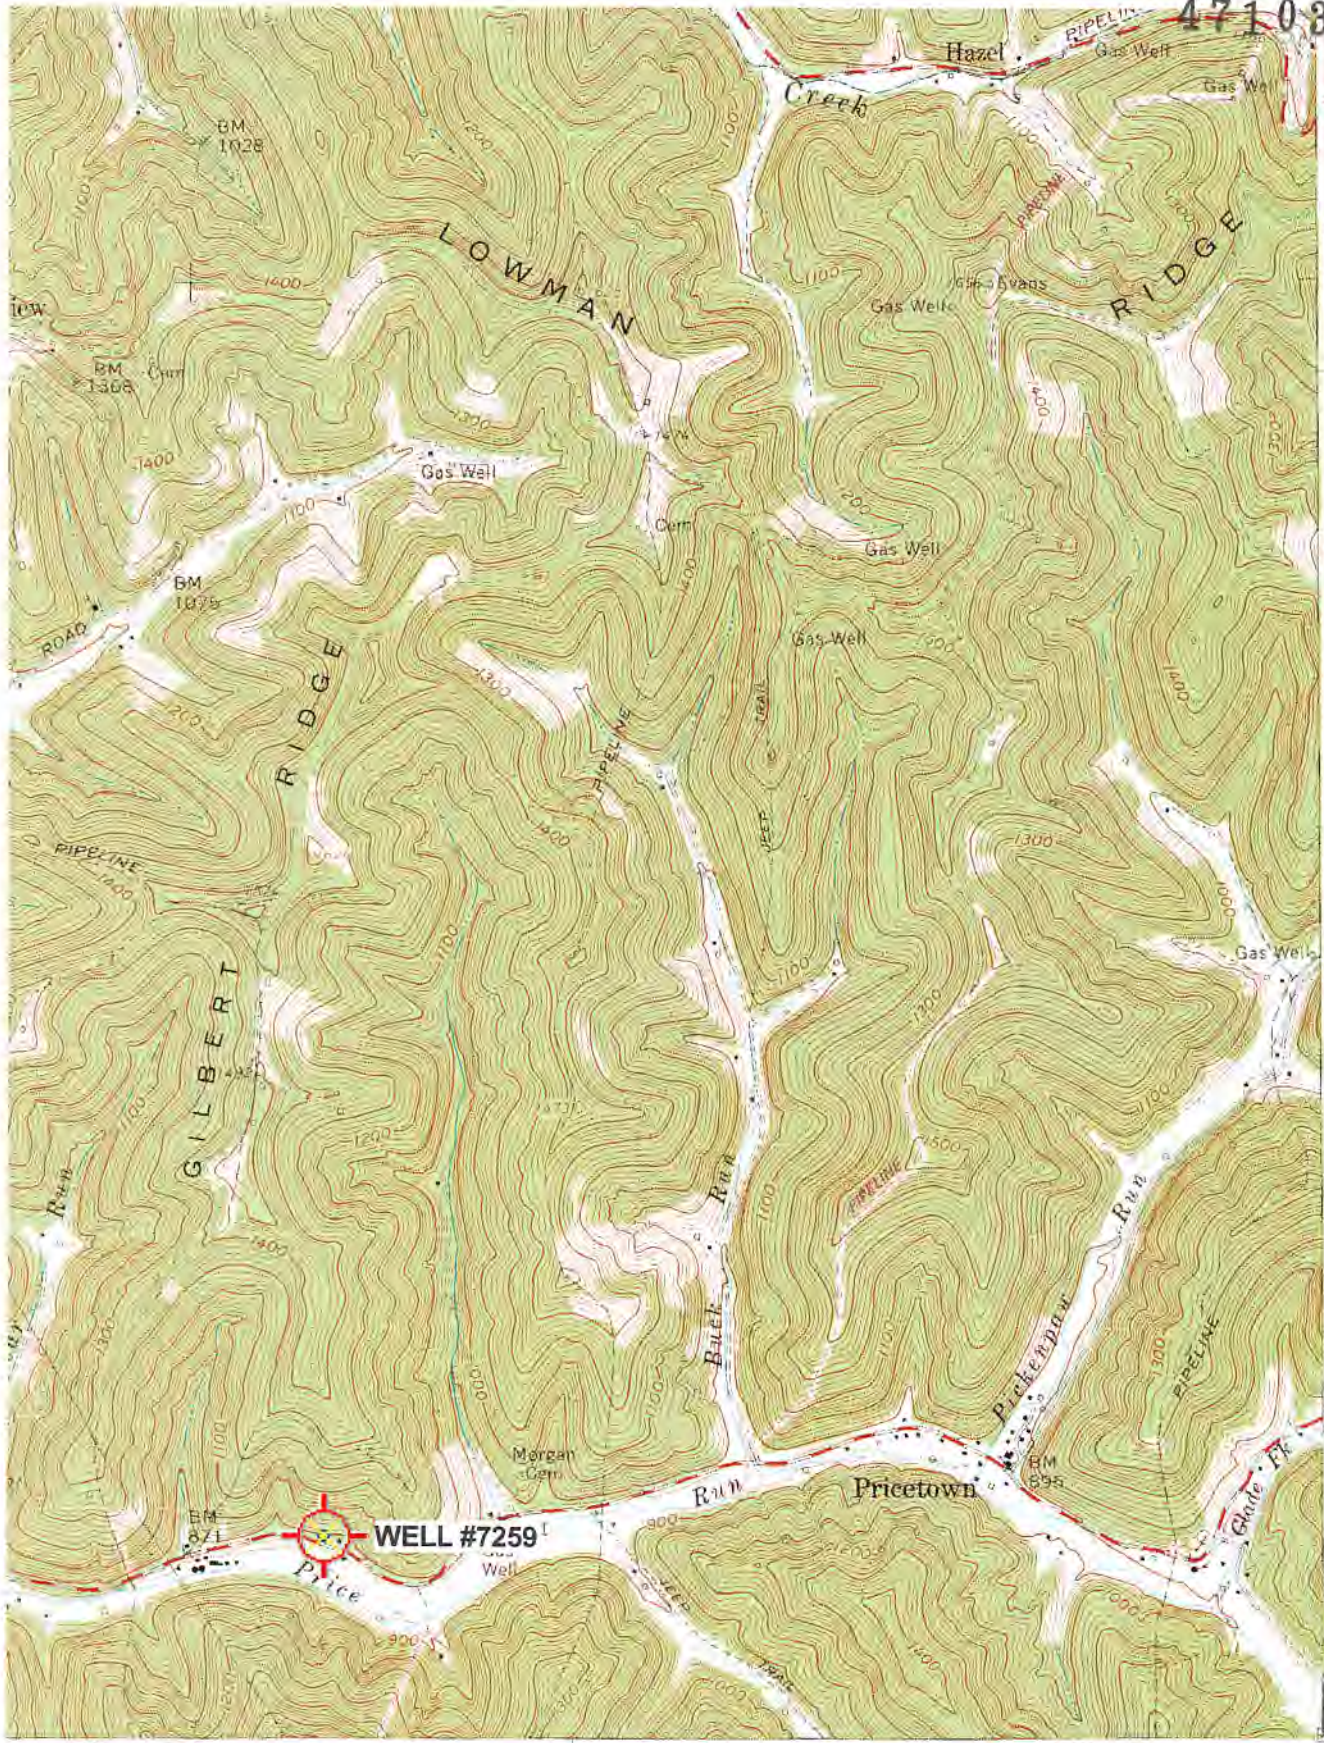

4871
32'30"
4876
4875
RECEIVED
Office of Oil and Gas
APR 29 2021
WV Department of Environmental Protection

(WALLACE)
2021 04 29

1 MILE
1000 FEET
1000 METERS

ROAD CLASSIFICATION
 Heavy-duty —————
 Medium-duty —————
 Light-duty —————
 Unimproved dirt —————
 State Route —————



'Big Run; WV' Scale: 1" = 0.379Mi 610M 2,000Ft, 1 Mi = 2.640' , 1 cm = 240M

BIG RUN, W. VA.

05/07/2021