

WW-7
8-30-06



West Virginia Department of Environmental Protection
Office of Oil and Gas

WELL LOCATION FORM: GPS

API: 47-103-03539 WELL NO.: 7257

FARM NAME: I.D. MORGAN

RESPONSIBLE PARTY NAME: WEST VIRGINIA LAND RESOURCES INC.

COUNTY: WETZEL DISTRICT: GRANT

QUADRANGLE: BIG RUN W.VA

SURFACE OWNER: MAGNOLIA LAND PARTNERS LLC.

ROYALTY OWNER: _____

UTM GPS NORTHING: 4,373,173 m (1112')

UTM GPS EASTING: 540,189 m GPS ELEVATION: 339 m

The Responsible Party named above has chosen to submit GPS coordinates in lieu of preparing a new well location plat for a plugging permit or assigned API number on the above well. The Office of Oil and Gas will not accept GPS coordinates that do not meet the following requirements:

1. Datum: NAD 1983, Zone: 17 North, Coordinate Units: meters, Altitude: height above mean sea level (MSL) – meters.
2. Accuracy to Datum – 3.05 meters
3. Data Collection Method:

Survey grade GPS _____ : Post Processed Differential _____
 Real-Time Differential _____
 Mapping Grade GPS X : Post Processed Differential X
 Real-Time Differential _____

RECEIVED
Office of Oil and Gas

OCT 31 2022

WV Department of
Environmental Protection

4. Letter size copy of the topography map showing the well location.

I the undersigned, hereby certify this data is correct to the best of my knowledge and belief and shows all the information required by law and the regulations issued and prescribed by the Office of Oil and Gas.

Signature

Professional Surveyor
Title


OCTOBER 13, 2022
Date




32'30"
477
476
475
474
473000N
39°30'

39 32'30" 40 41 80°30'

INTERIOR-GEOLOGICAL SURVEY, RESTON, VIRGINIA-1977
642000E

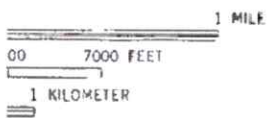

RECEIVED
Office of Oil and Gas
OCT 31 2022

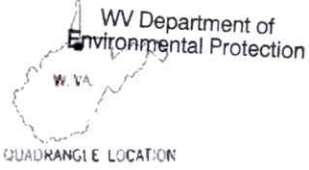

ROAD CLASSIFICATION

Heavy-duty	—————	Light-duty	—————
Medium-duty	—————	Unimproved dirt	-----
		Slate Route	—————

(WALLACE)
4882 N NW

BIG RUN, W. VA.

SE 1/4 LITTLETON 15' QUADRANGLE
N3930—W8030/7.5

12/16/2022