

47 103 03 569f

WW-7
8-30-06



West Virginia Department of Environmental Protection
Office of Oil and Gas

WELL LOCATION FORM: GPS

API: 47-103- WELL NO.: 7314

FARM NAME: I.D. MORGAN

RESPONSIBLE PARTY NAME: WEST VIRGINIA LAND RESOURCES INC.

COUNTY: WETZEL DISTRICT: GRANT

QUADRANGLE: BIG RUN W.VA

SURFACE OWNER: MICHAEL A. BAKER SR.

ROYALTY OWNER: _____

UTM GPS NORTHING: 4,373,964 m (1309')

UTM GPS EASTING: 539,993 m GPS ELEVATION: 399 m

The Responsible Party named above has chosen to submit GPS coordinates in lieu of preparing a new well location plat for a plugging permit or assigned API number on the above well. The Office of Oil and Gas will not accept GPS coordinates that do not meet the following requirements:

- Datum: NAD 1983, Zone: 17 North, Coordinate Units: meters, Altitude: height above mean sea level (MSL) – meters.
- Accuracy to Datum – 3.05 meters
- Data Collection Method:

Survey grade GPS _____: Post Processed Differential _____


Real-Time Differential _____

Mapping Grade GPS X: Post Processed Differential X

Real-Time Differential _____

- Letter size copy of the topography map showing the well location.

I the undersigned, hereby certify this data is correct to the best of my knowledge and belief and shows all the information required by law and the regulations issued and prescribed by the Office of Oil and Gas.

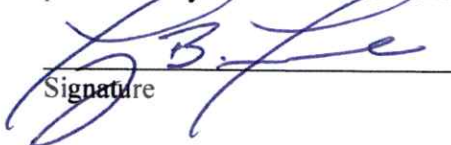
Signature

Professional Surveyor
Title

FEBRUARY 6, 2023
Date

RECEIVED
Office of Oil and Gas
MAR 03 2023
WV Department of
Environmental Protection

Steph 03/17/2023



4710303569P



4377
32'30"
4376
4375
RECEIVED
Office of Oil and G
MAR 03 2023
WV Department of
Environmental Protectio

39°30'
80°30'
(WALLACE)
4982 N NW

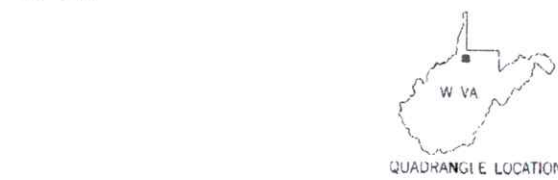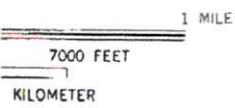

ROAD CLASSIFICATION

Heavy-duty		Light-duty	
Medium-duty		Unimproved dirt	
		Slate Route	

BIG RUN, W. VA.
SE/4 LITTLETON 15' QUADRANGLE
N3930—W8030/7.5

Big Run; WV Scale: 1" = 0.379Mi 610Mt 2,000Ft. 1 Mi = 2,640' . 1 cm = 240Mt

03/17/2023