


'Big Run: WV' Scale; 1" = 0.379Mi_610Mt_2.000Ft_1 Mi = 2.640* _1 cm = 240Mt

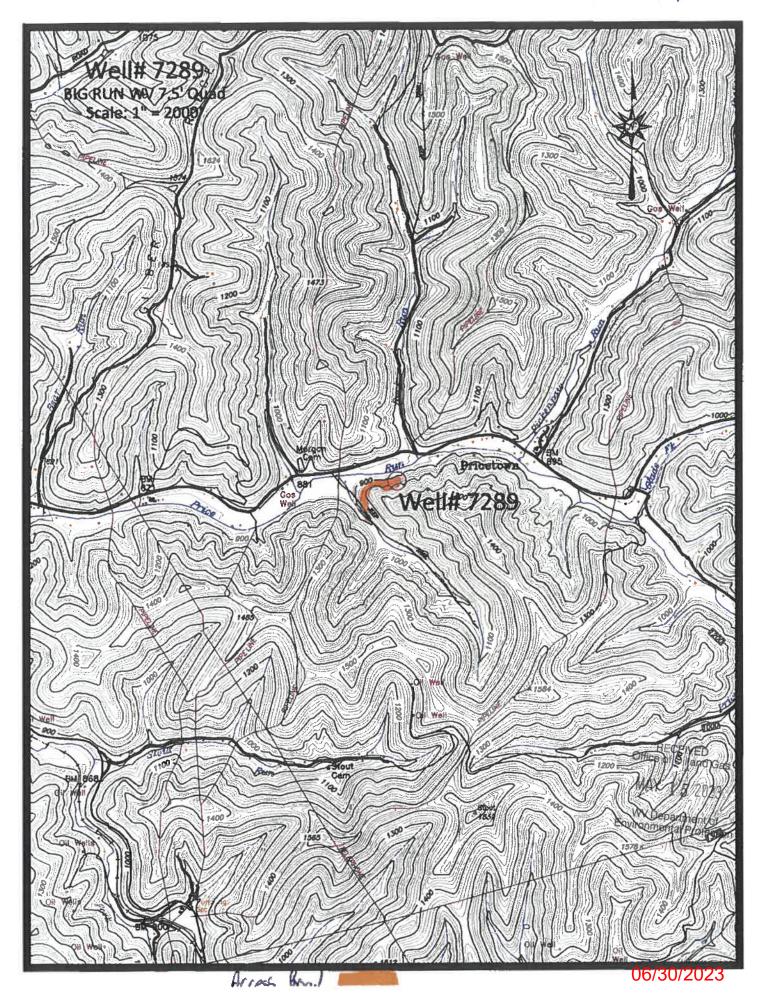

WW-7 8-30-06



West Virginia Department of Environmental Protection Office of Oil and Gas

WELL LOCATION FORM: GPS

API: 47-103-30694 WELL NO.: 7289	2
API: 47-103-30694 WELL NO.: 7289 FARM NAME: I. D. MORGAN	:
RESPONSIBLE PARTY NAME: WEST VIRGINIA LAND RESOURCES INC.	
COUNTY: WEIZEL DISTRICT: GRANT	
QUADRANGLE: BIG RUN W.VA	
SURFACE OWNER: ROBERT M. ROE	-
ROYALTY OWNER:	e
UTM GPS NORTHING: 4,373,084 m (964')	
UTM GPS NORTHING: 4,373,084 m (964') UTM GPS EASTING: 541,091 m GPS ELEVATION: 294 m	2
The Responsible Party named above has chosen to submit GPS coordinates in lieu of preparing a new well location plat for a plugging permit or assigned API number on the above well. The Office of Oil and Gas will not accept GPS coordinates that do not meet the following requirements: 1. Datum: NAD 1983, Zone: 17 North, Coordinate Units: meters, Altitude: height above mean sea level (MSL) – meters. 2. Accuracy to Datum – 3.05 meters 3. Data Collection Method: Survey grade GPS: Post Processed Differential	
Real-Time Differential X Mapping Grade GPS X: Post Processed Differential	RECEIVED Office of Oil and Gas
	MAY 15 2023
Real-Time Differential	WV Department of
4. Letter size copy of the topography map showing the well location. I the undersigned, hereby certify this data is correct to the best of my knowledge and belief and shows all the information required by law and the regulations issued and prescribed by the Office of Office	nvironmental Protection
Professional Surveyor MARCH 14, 2023	i -
Signature Title Date	