

4710303638  
 42'30"  
 42'76"  
 42'75"  
 42'74"  
 42'30000N  
 39'30"

39 32'30" 40 41 642000E



ROAD CLASSIFICATION

- Heavy-duty ——— Light-duty ———
- Medium-duty ——— Unimproved dirt ———
- State Route ———



QUADRANGLE LOCATION

Big Run: WV Scale: 1" = 0.379Mi 610M 2 000Ft 1 Mi = 2 640' 1 cm = 240M

BIG RUN, W. VA.  
 SE/4 LITTLETON 15' QUADRANGLE  
 N3930—W8030/7.5

12/15/2023

DEC 05 2023  
 WV Department of Environmental Protection (WALLACE)

Well# 7455  
BIG RUN WV 7.5' Quad  
Scale: 1" = 2000'




Well# 7455

Pricetown

WV Department of  
Environmental Protection

12/15/2023

Address km 1

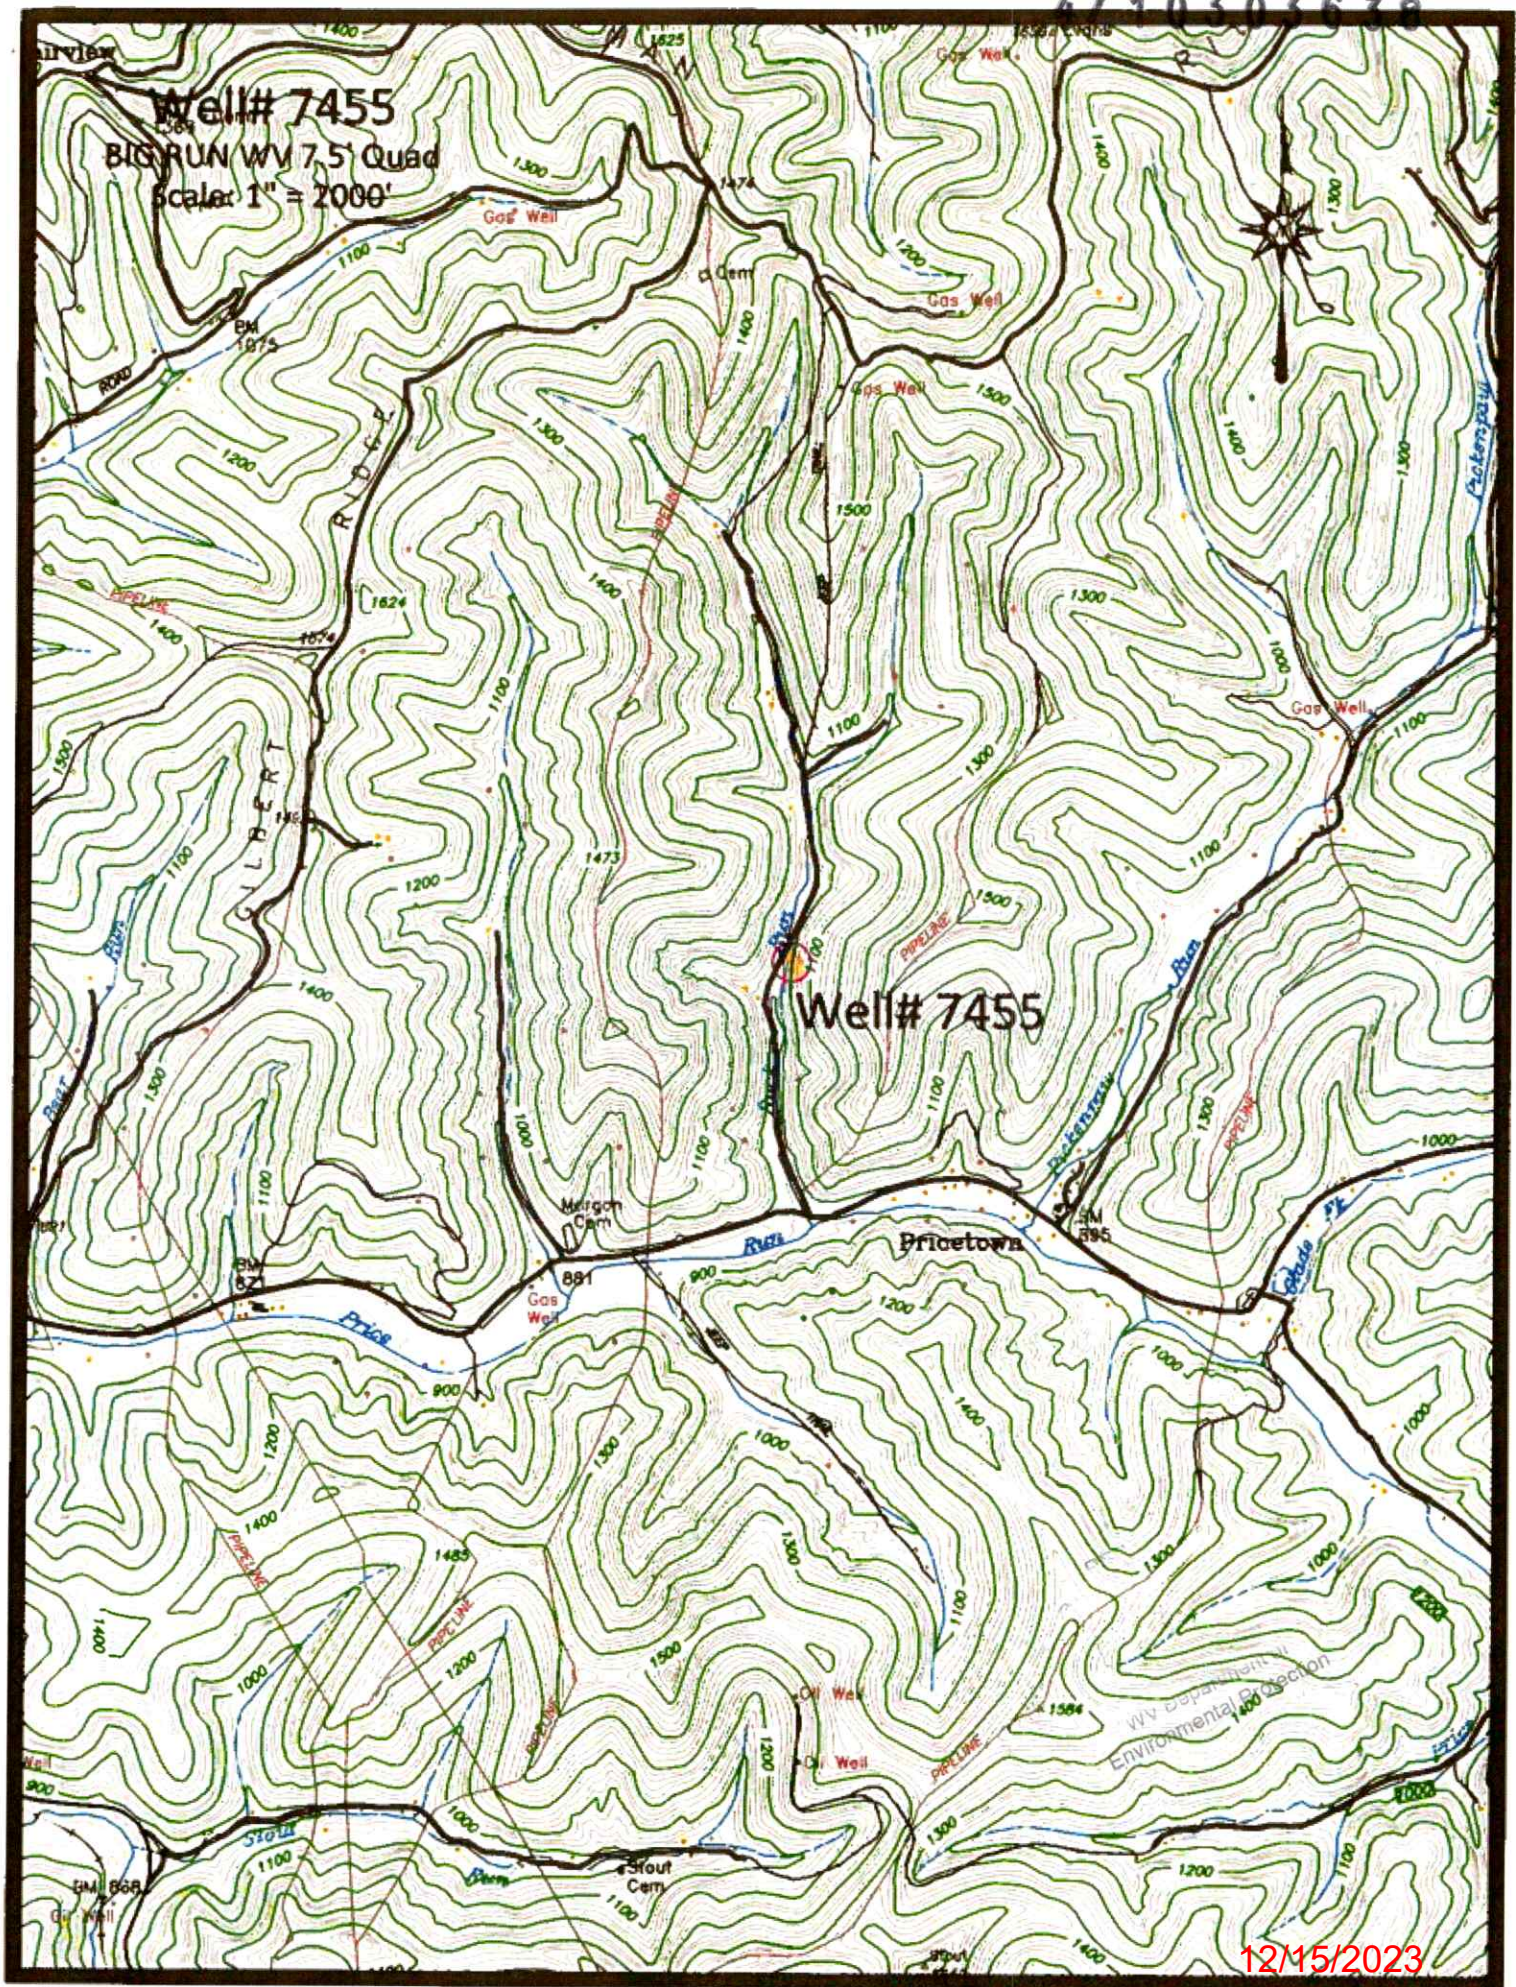

WW-7  
8-30-06



West Virginia Department of Environmental Protection  
Office of Oil and Gas

WELL LOCATION FORM: GPS

API: 47-103-72326 WELL NO.: 7455

FARM NAME: LINDSEY STEWART

RESPONSIBLE PARTY NAME: WEST VIRGINIA LAND RESOURCES INC.

COUNTY: WETZEL DISTRICT: GRANT

QUADRANGLE: BIG RUN W.VA

SURFACE OWNER: SARAH J. GOODRICH ETAL

ROYALTY OWNER: \_\_\_\_\_

UTM GPS NORTHING: 4,374,065 m

UTM GPS EASTING: 541,152 m GPS ELEVATION: 300 m

RECEIVED  
Office of Oil and Gas

The Responsible Party named above has chosen to submit GPS coordinates in lieu of preparing a new well location plat for a plugging permit or assigned API number on the above well. The Office of Oil and Gas will not accept GPS coordinates that do not meet the following requirements:

1. Datum: NAD 1983, Zone: 17 North, Coordinate Units: meters, Altitude: height above mean sea level (MSL) – meters.
2. Accuracy to Datum – 3.05 meters
3. Data Collection Method:

Survey grade GPS \_\_\_\_\_: Post Processed Differential \_\_\_\_\_

Real-Time Differential \_\_\_\_\_

Mapping Grade GPS X: Post Processed Differential X

Real-Time Differential \_\_\_\_\_

4. Letter size copy of the topography map showing the well location.

I the undersigned, hereby certify this data is correct to the best of my knowledge and belief and shows all the information required by law and the regulations issued and prescribed by the Office of Oil and Gas.

[Signature]  
Signature

PS2002  
Title

NOVEMBER 21, 2023  
Date

12/15/2023