


47 1 0 3 0 3 6 4 6

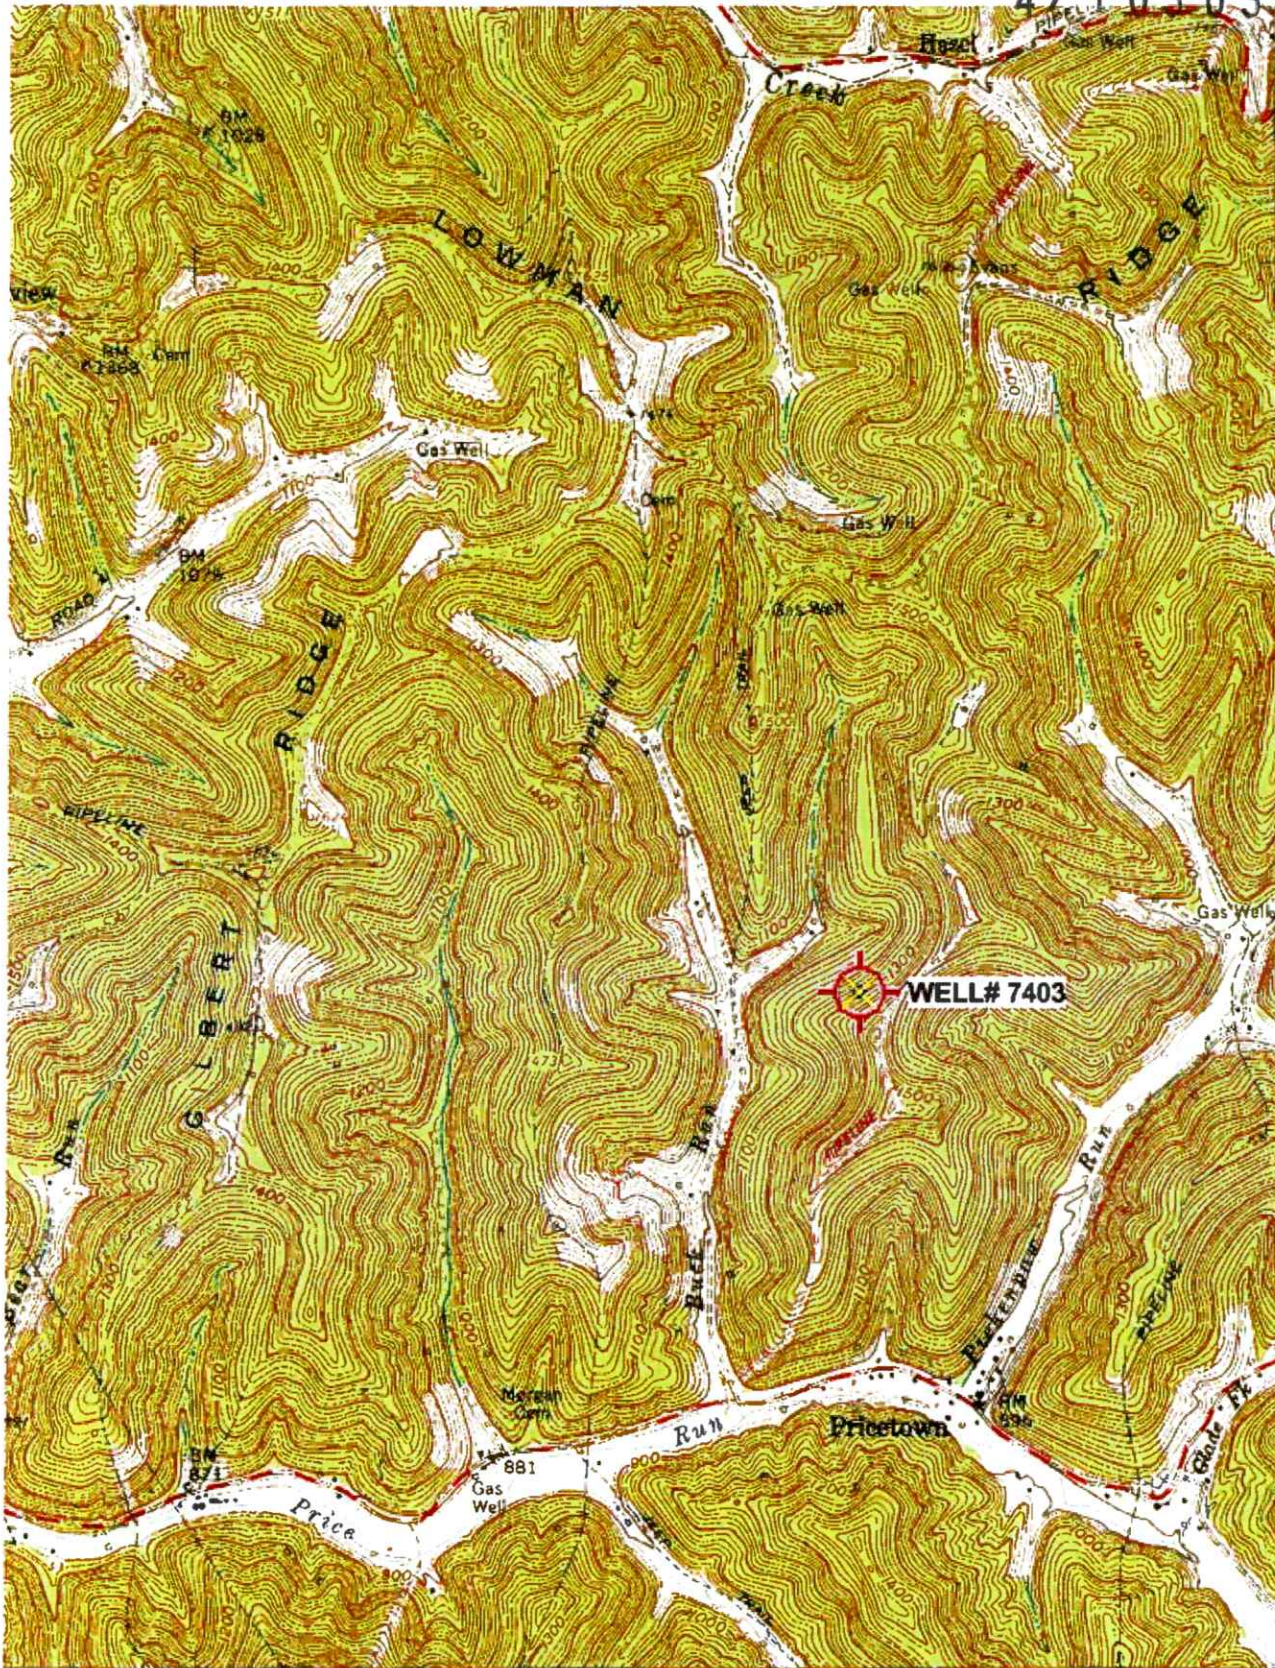

4177  
32'30"  
4176  
4175  
4174  
39°30'

RECEIVED  
Office of Oil and Gas  
MAR 15 2024  
WV Department of Environmental Protection

39 32'30" 40 41 80°30'



ROAD CLASSIFICATION

Heavy-duty		Light-duty	
Medium-duty		Unimproved dirt	
		Slate Route	



'Big Run; WV Scale: 1" = 0.379Mi 610Mt 2,000Ft, 1 Mi = 2.640" , 1 cm = 240Mt

BIG RUN, W. VA. 04/05/2024

(WALLACE)  
482 IV NW

