



4710303653

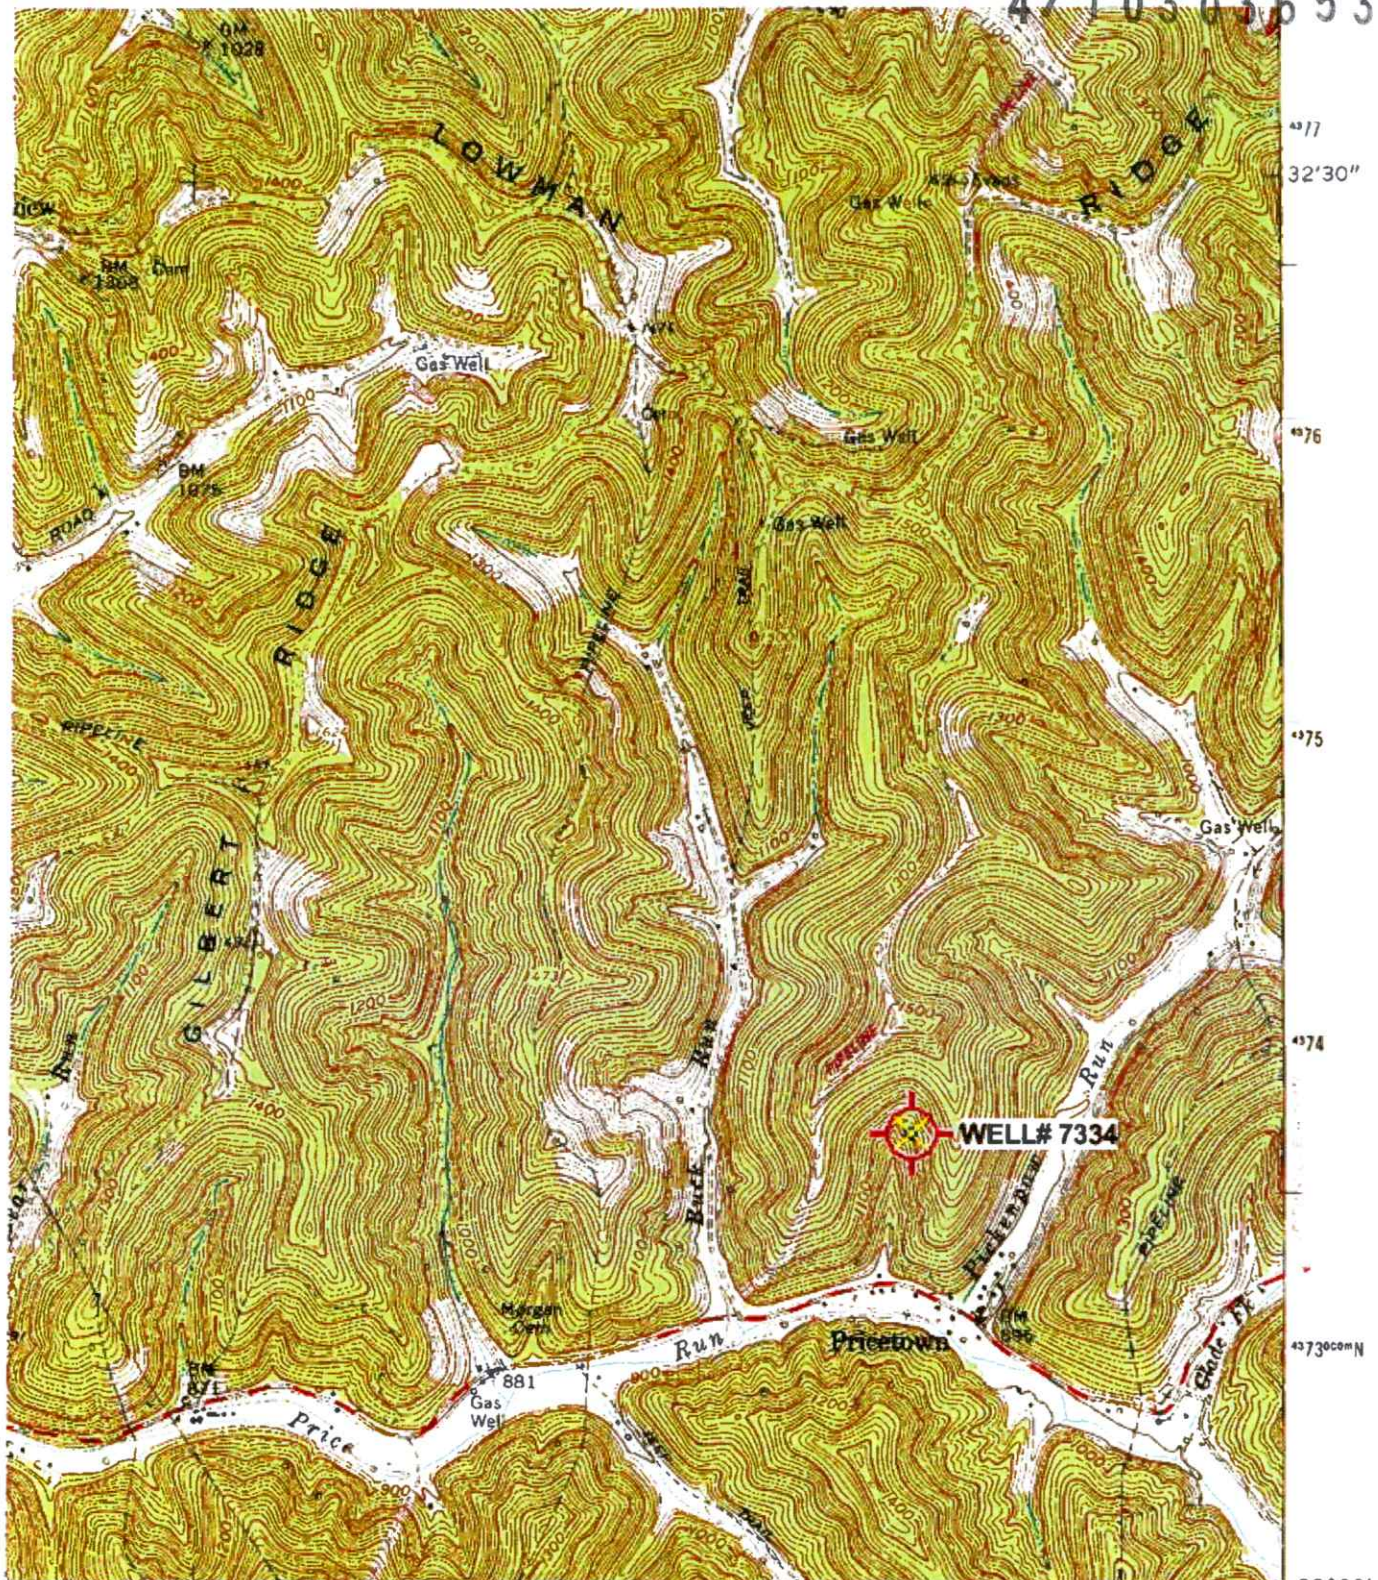

39 32'30" 40 Office of Oil and Gas 41 80°30' 39°30'

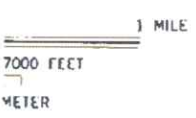

MAR 26 2024

WV Department of Environmental Protection



ROAD CLASSIFICATION

- Heavy-duty ————
- Medium-duty ————
- Light-duty ————
- Unimproved dirt - - - - -
- State Route ————

(WALLACE)  
1982 IV NW


BIG RUN, W. VA.

SE/4 LITTLETON 15' QUADRANGLE  
N3930—W8030/7.5

'Big Run; WV Scale: 1" = 0.379Mi 610Mt 2,000Ft, 1 Mi = 2.640" , 1 cm = 240Mt

1960

04/19/2024

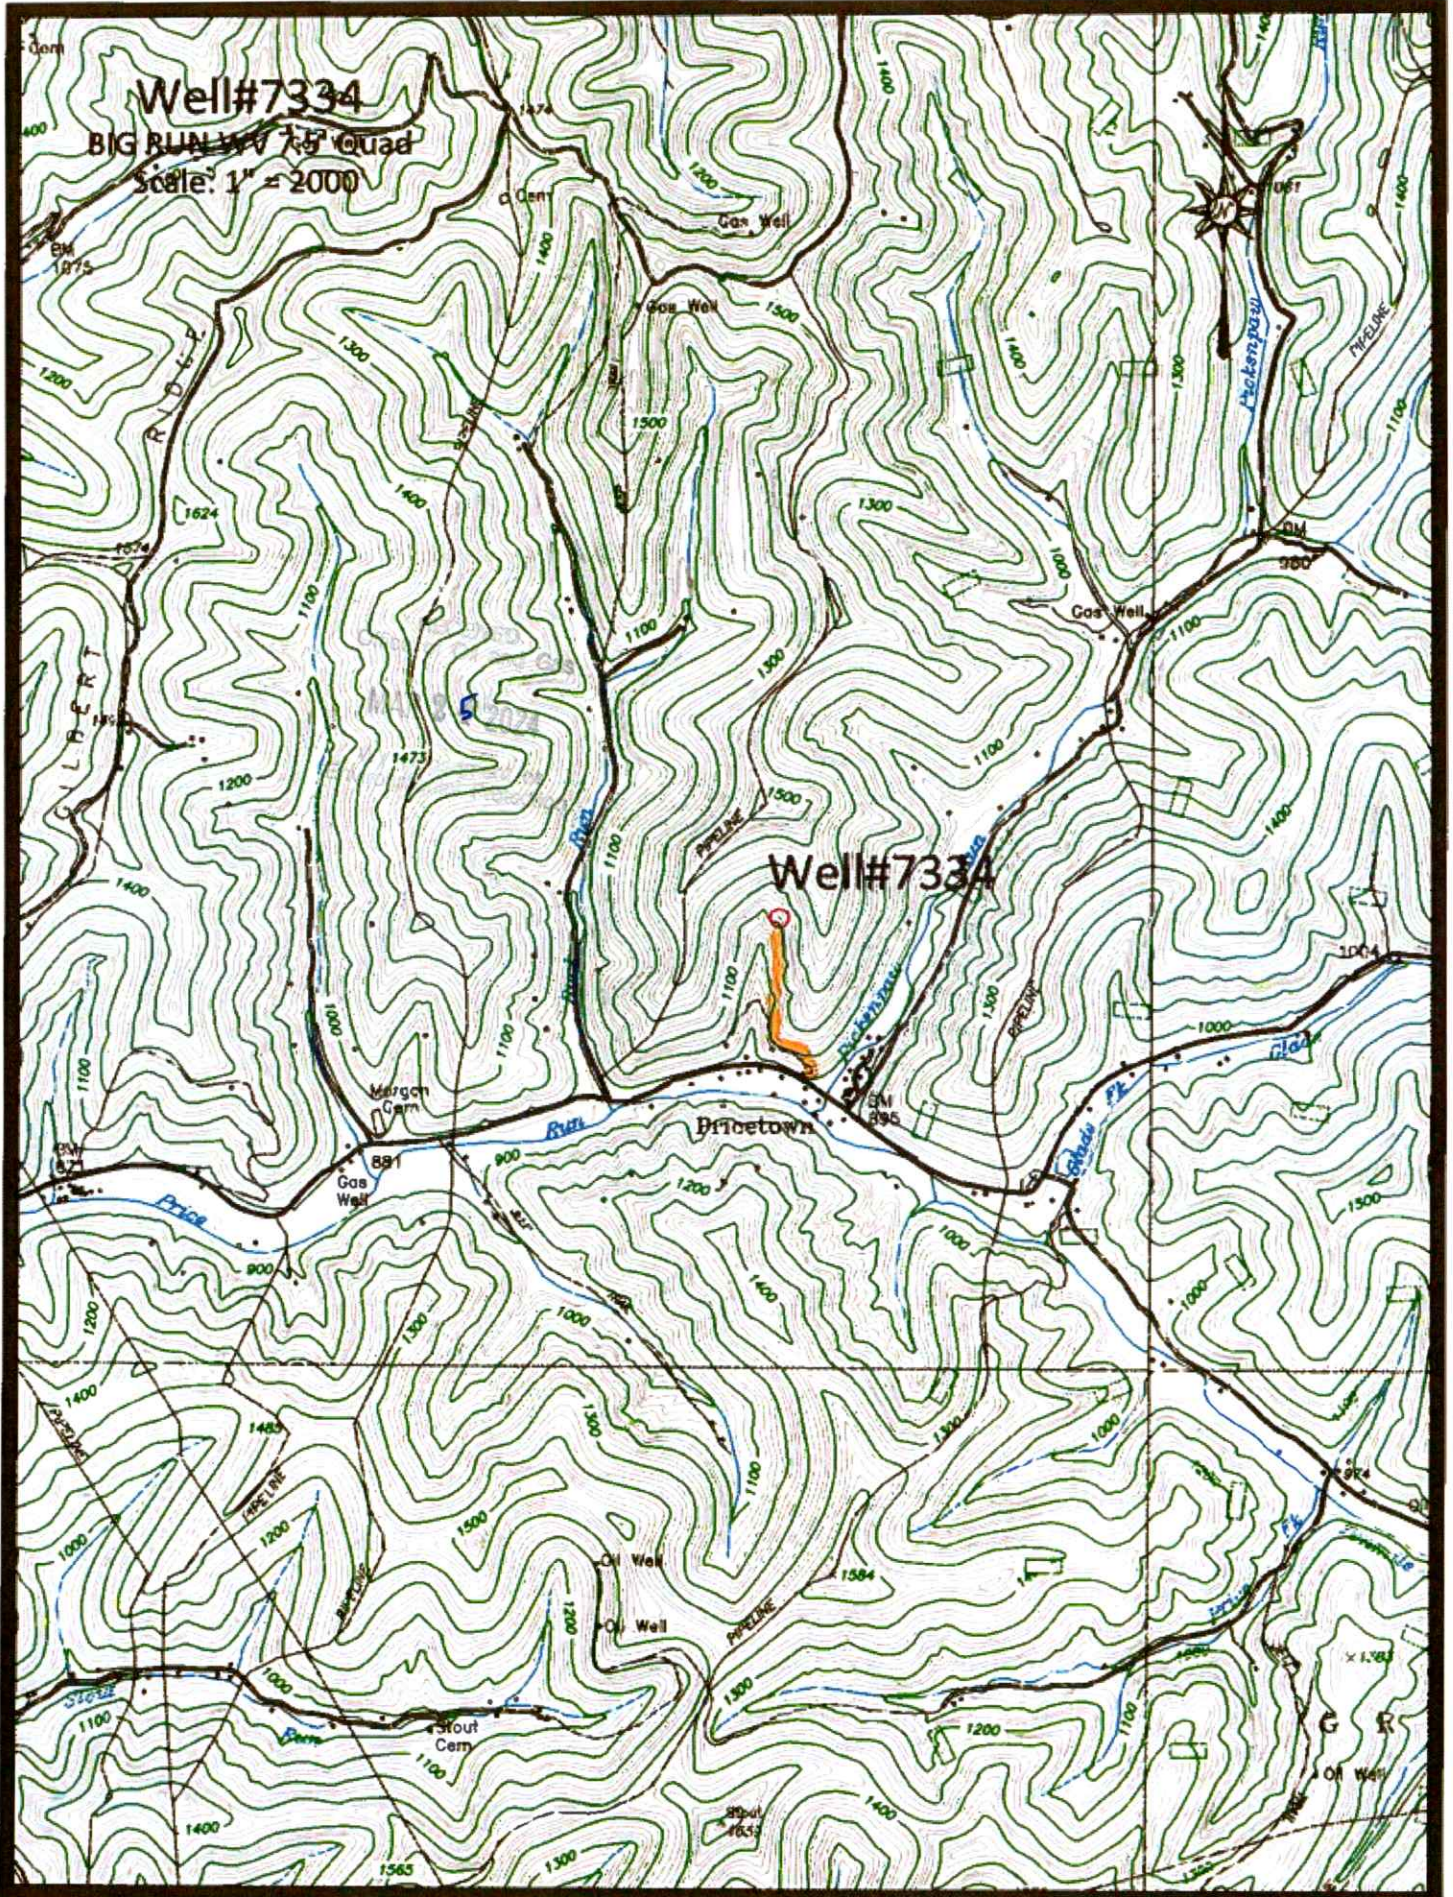

Access Road

04/19/2024

47 103 036 53

RECEIVED  
Office of Oil and Gas

MAR 25 2024

WV Department of  
Environmental Protection

WW-7  
8-30-06



West Virginia Department of Environmental Protection  
Office of Oil and Gas  
**WELL LOCATION FORM: GPS**

API: 47-103-72194 WELL NO.: 7334

FARM NAME: W T PRICE 2

RESPONSIBLE PARTY NAME: WEST VIRGINIA LAND RESOURCES INC.

COUNTY: WETZEL DISTRICT: GRANT

QUADRANGLE: BIG RUN WV

SURFACE OWNER: DAVID MICHAEL BURR

ROYALTY OWNER: \_\_\_\_\_

UTM GPS NORTHING: 4,373,867 m

UTM GPS EASTING: 541,777 m GPS ELEVATION: 348 m

The Responsible Party named above has chosen to submit GPS coordinates in lieu of preparing a new well location plat for a plugging permit or assigned API number on the above well. The Office of Oil and Gas will not accept GPS coordinates that do not meet the following requirements:

1. Datum: NAD 1983, Zone: 17 North, Coordinate Units: meters, Altitude: height above mean sea level (MSL) – meters.
2. Accuracy to Datum – 3.05 meters
3. Data Collection Method:

Survey grade GPS \_\_\_\_\_: Post Processed Differential \_\_\_\_\_


Real-Time Differential \_\_\_\_\_

Mapping Grade GPS : Post Processed Differential

Real-Time Differential \_\_\_\_\_

4. Letter size copy of the topography map showing the well location.

I the undersigned, hereby certify this data is correct to the best of my knowledge and belief and shows all the information required by law and the regulations issued and prescribed by the Office of Oil and Gas.

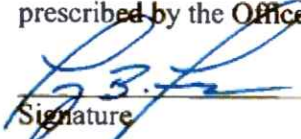  
Signature

PS 2002  
Title

MARCH 20, 2024  
Date

04/19/2024