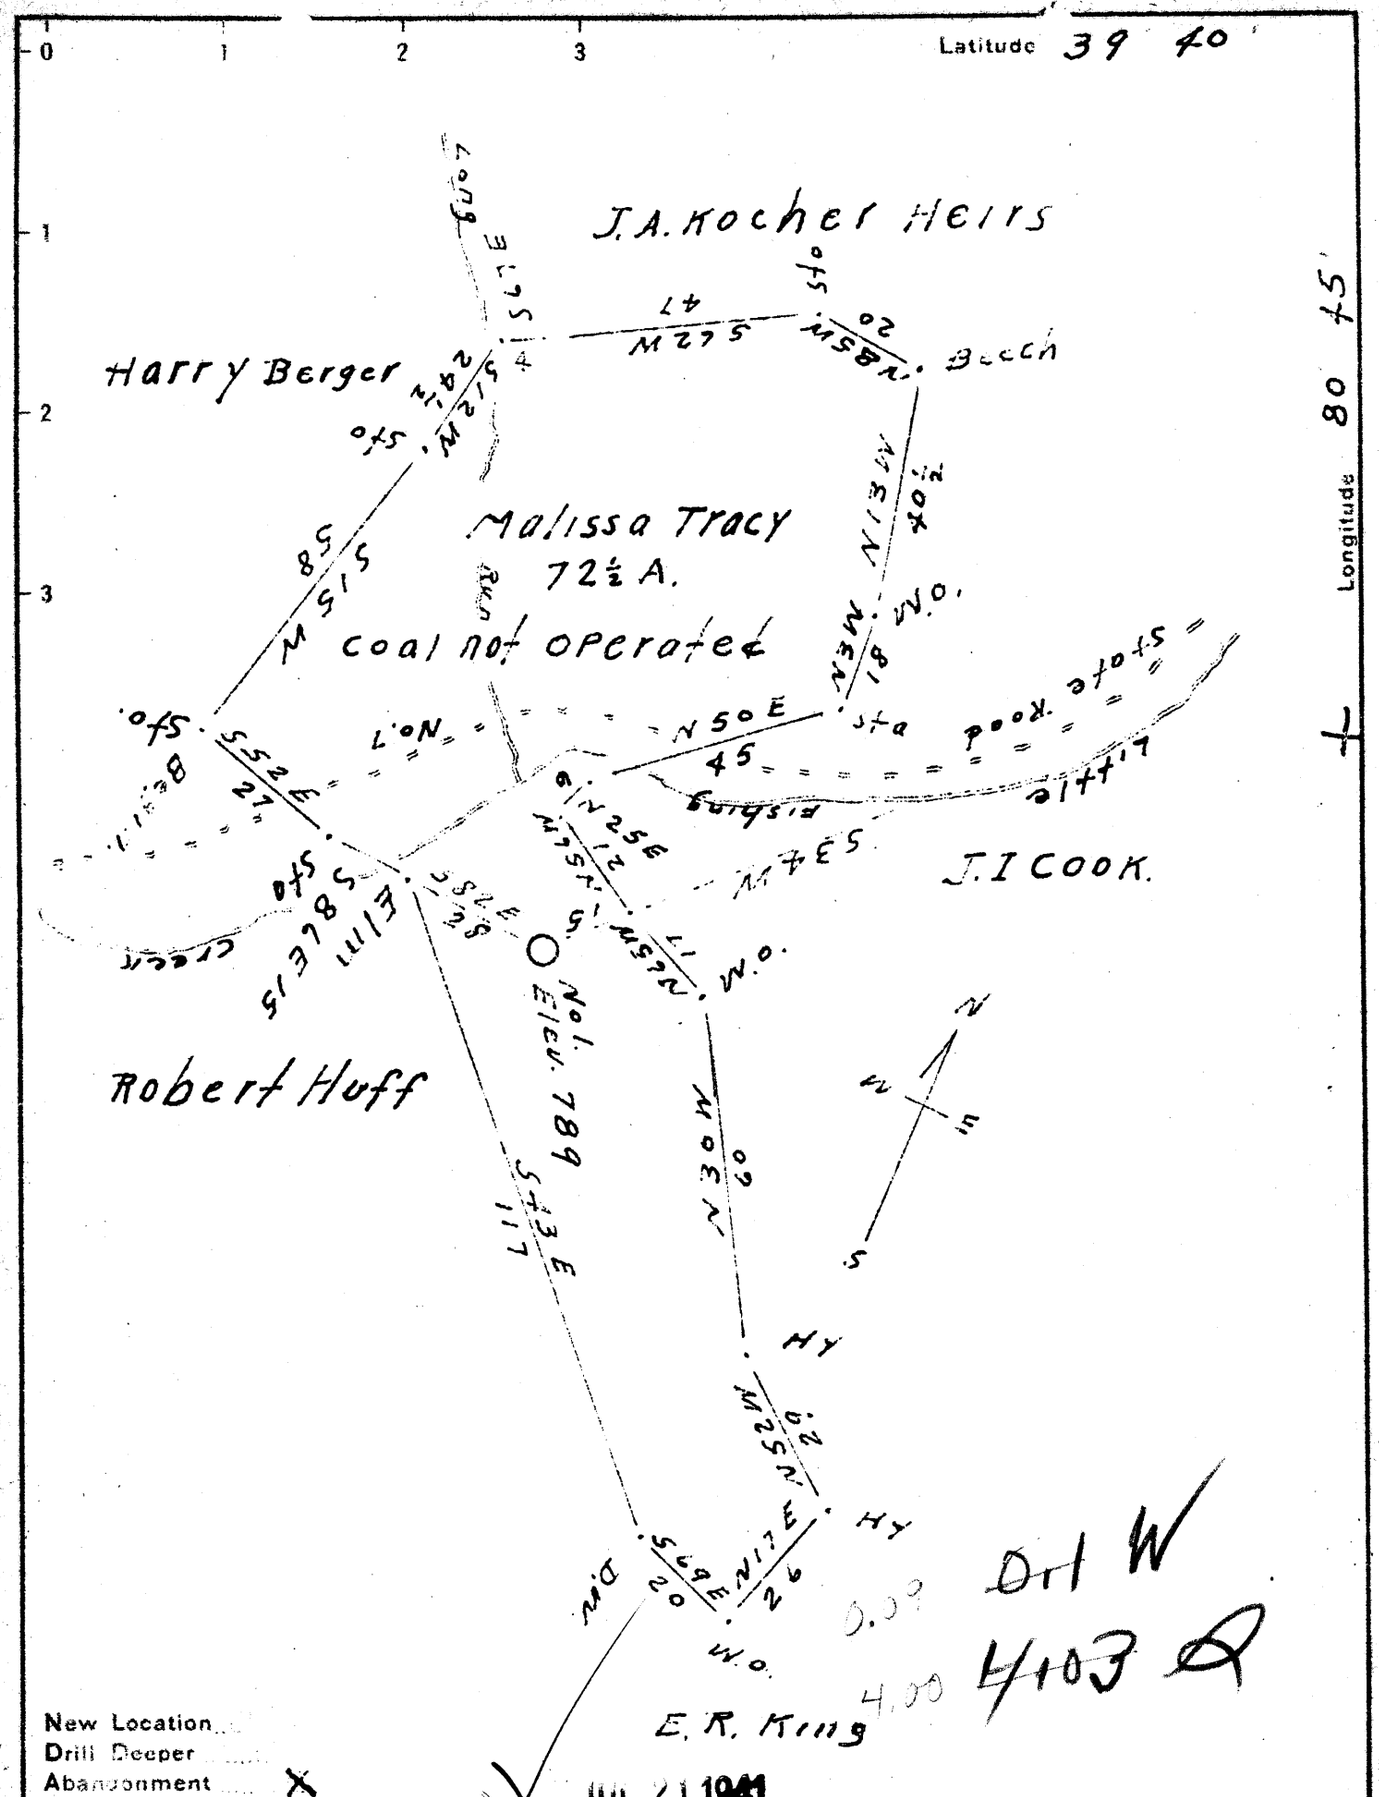

Drl W

4103 A

New Location ...
Drill Deeper ...
Abandonment ... X

JUL 21 1941

Company J. C. Crouch.
Address Sistersville W.Va.
Farm Melissa Tracy
Tract 1 Acres 72½ Lease No. ...
Well (Farm) No. 1 Serial No. ...
Elevation (Spirit Level) 789 Feet
Quadrangle New Martinsville
County Wetzel District Green
Engineer J. M. Cochran
Engineer's Registration No. Co. Surveyor
File No. ... Drawing No. ...
Date 3-24-1941 Scale 1 in = 30 Rods

STATE OF WEST VIRGINIA
DEPARTMENT OF MINES
OIL AND GAS DIVISION
CHARLESTON

WELL LOCATION MAP
FILE NO. WET-364A

+ Denotes location of well on United States Topographic Maps, scale 1 to 62,500, latitude and longitude lines being represented by border lines as shown.

— Denotes one inch spaces on border line of original tracing.

PRINTED ON KEUFFEL & ESSER CO. TRACING CLOTH

MELISSA TRACY No. 1 — J.C. CROUCH — WET-364-A