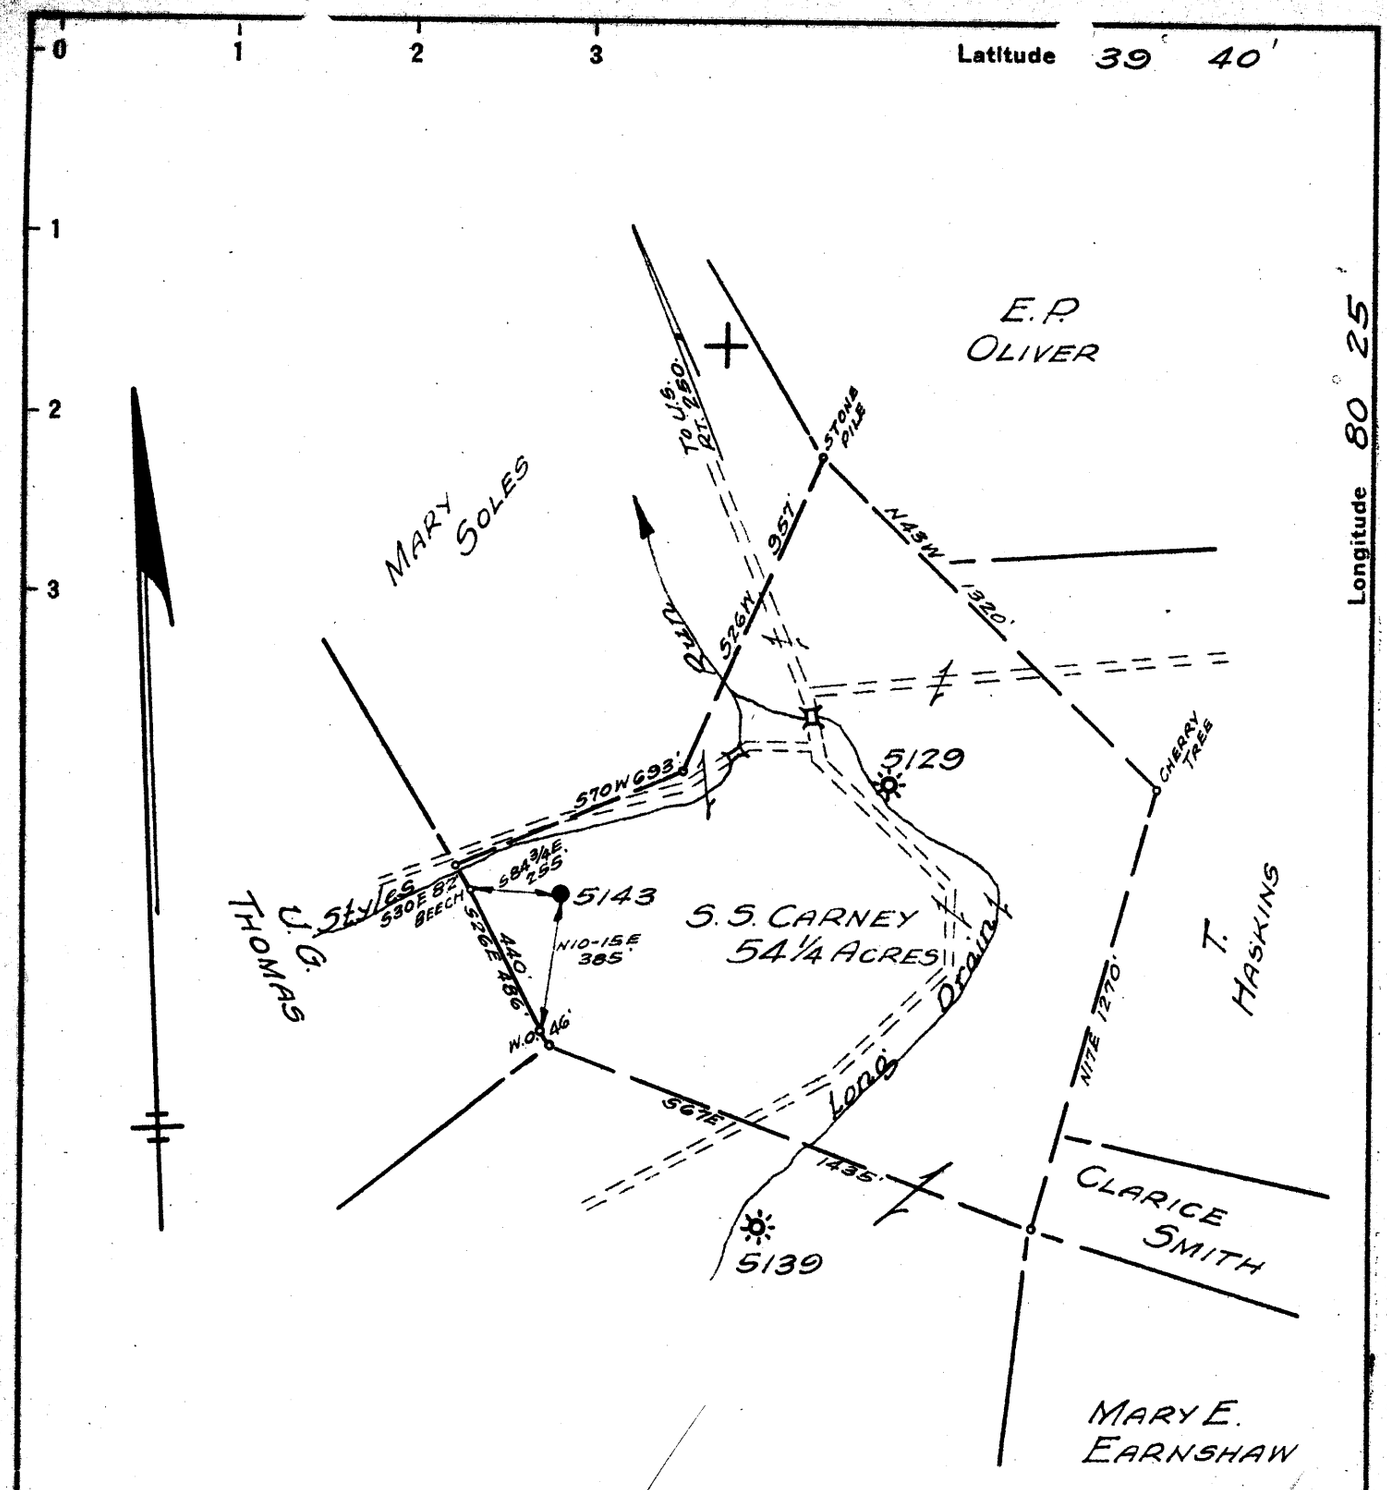

3.58 ~~3.64~~ W

1.78 ~~1.81~~

SEP 22 1941

New Location ☐
Drill Deeper ☐
Abandonment ☒

FORMERLY — PHILADELPHIA OIL CO.

Company GEORGE JACKSON GAS CO.
Address CLARKSBURG, W.VA.
Farm S.S. CARNEY
Tract _____ Acres 124 Lease No. 3494
Well (Farm) No. THREE Serial No. 5143
Elevation (Spirit Level) 1153' V.A.
Quadrangle MANNINGTON N.W. 3 3
County WETZEL District CHURCH
Engineer Paul W. Cunningham
Engineer's Registration No. _____
File No. V-98.P-13. Drawing No. _____
Date MAY 29, 1941 Scale 1" = 500'

STATE OF WEST VIRGINIA
DEPARTMENT OF MINES
OIL AND GAS DIVISION
CHARLESTON

WELL LOCATION MAP

FILE NO. WET-374A

+ Denotes location of well on United States Topographic Maps, scale 1 to 62,500, latitude and longitude lines being represented by border lines as shown.

— Denotes one inch spaces on border line of original tracing.

S.S. CARNEY No. 3 (5143) — GEORGE JACKSON GAS CO. — WET-374A