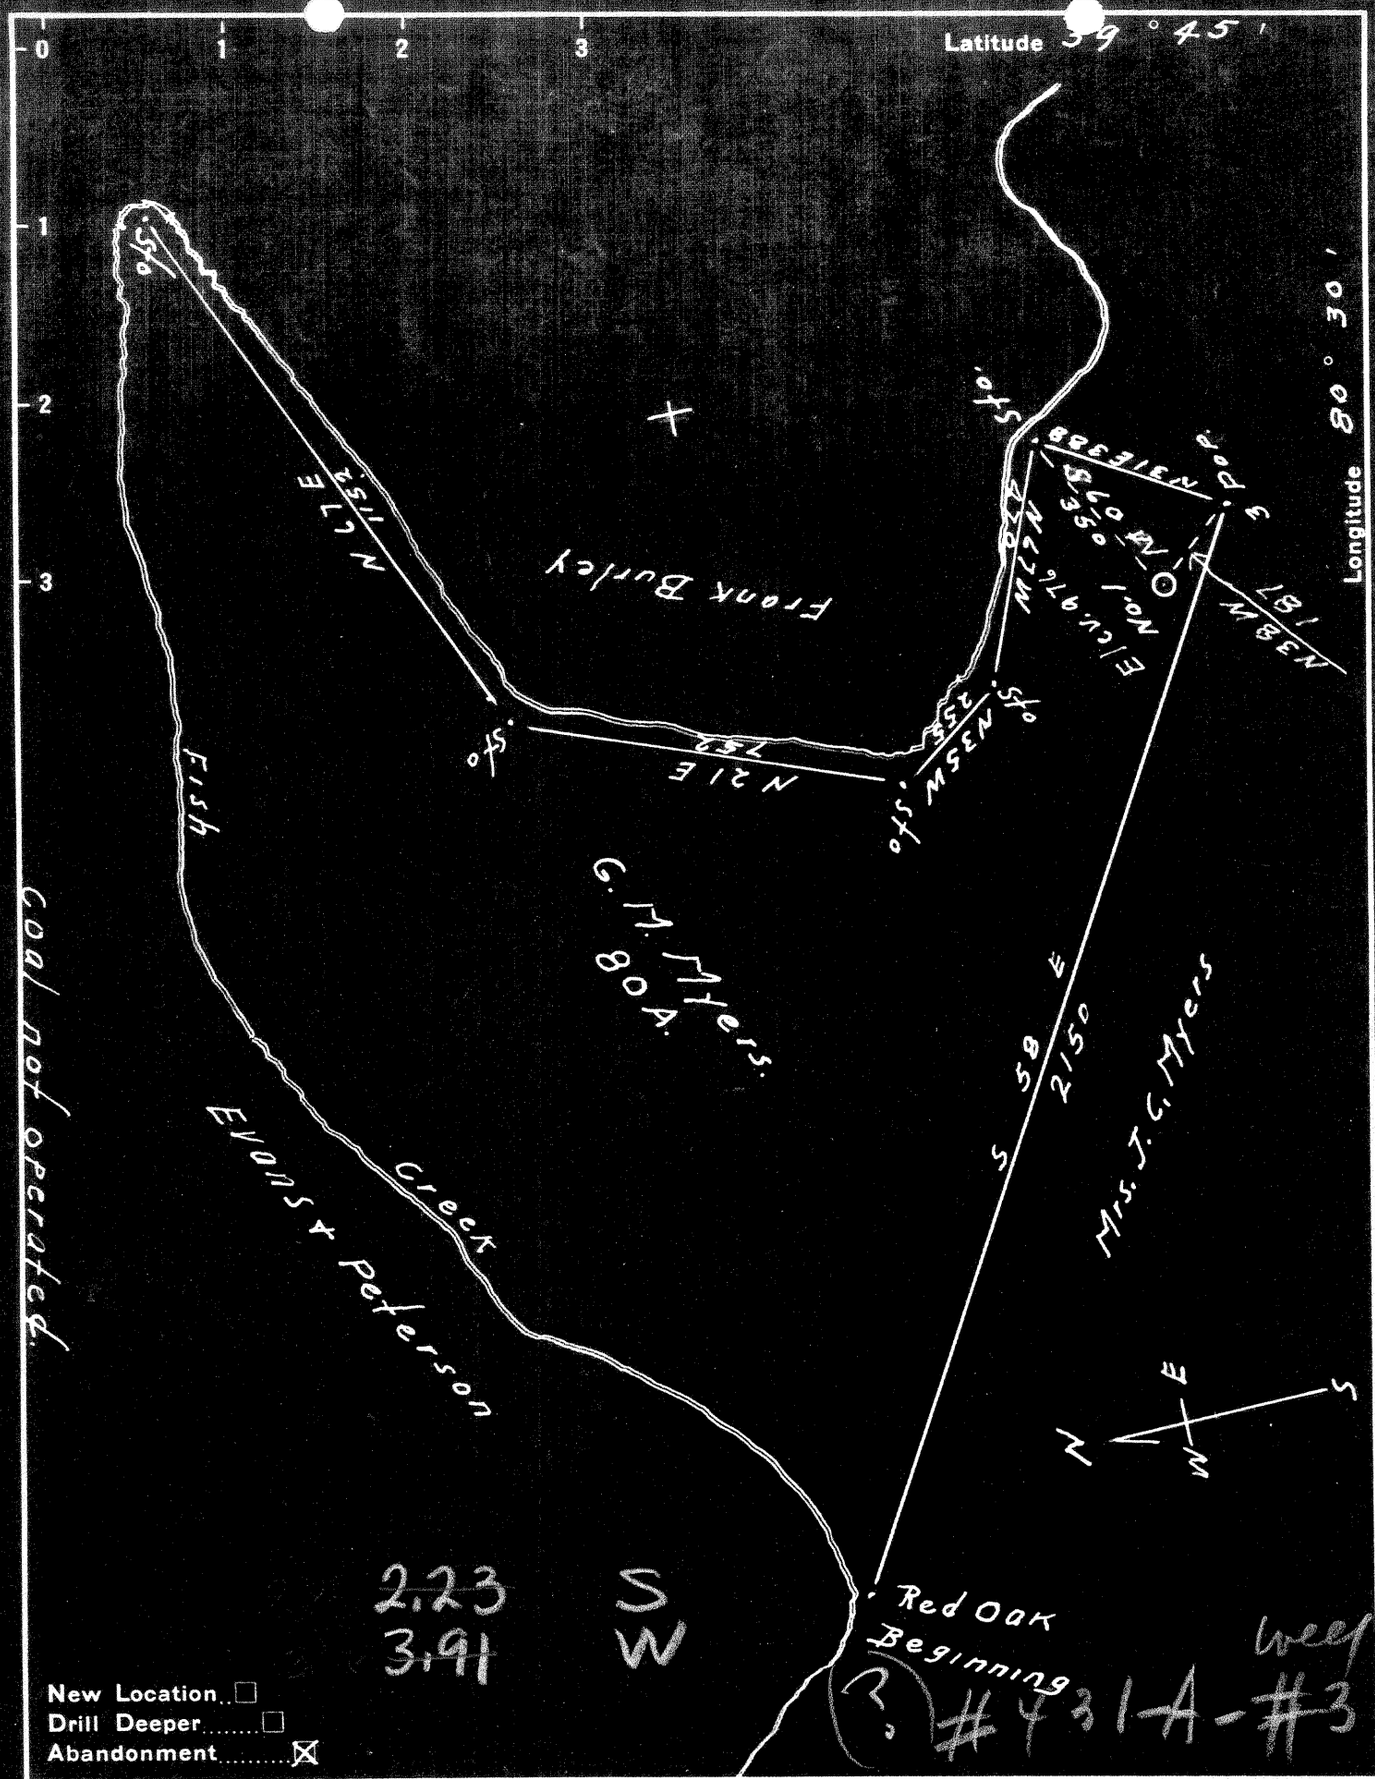

Company A. G. Isiminger, Et-al's.
Address Cameron West Va.
Farm G. M. Myers
Tract One Acres 80 Lease No. NE
Well (Farm) No. One Serial No.
Elevation (Spirit Level) 976
Quadrangle Littleton
County Wetzel District Center
Engineer J. M. Cochran
Engineer's Registration No. Co. Surveyor
File No. Drawing No.
Date 9-9-1942 Scale 1-in = 330 Feet

STATE OF WEST VIRGINIA
DEPARTMENT OF MINES
OIL AND GAS DIVISION
CHARLESTON

WELL LOCATION MAP

FILE NO. WET-1100 A #1

+ Denotes location of well on United States Topographic Maps, scale 1 to 62,500, latitude and longitude lines being represented by border lines as shown.

— Denotes one inch spaces on border line of original tracing.

"IMPERIAL" TRACING CLOTH
K & E CO., N. Y.