Latitude 39 ° 40 '

Longitude 80 ° 35 '

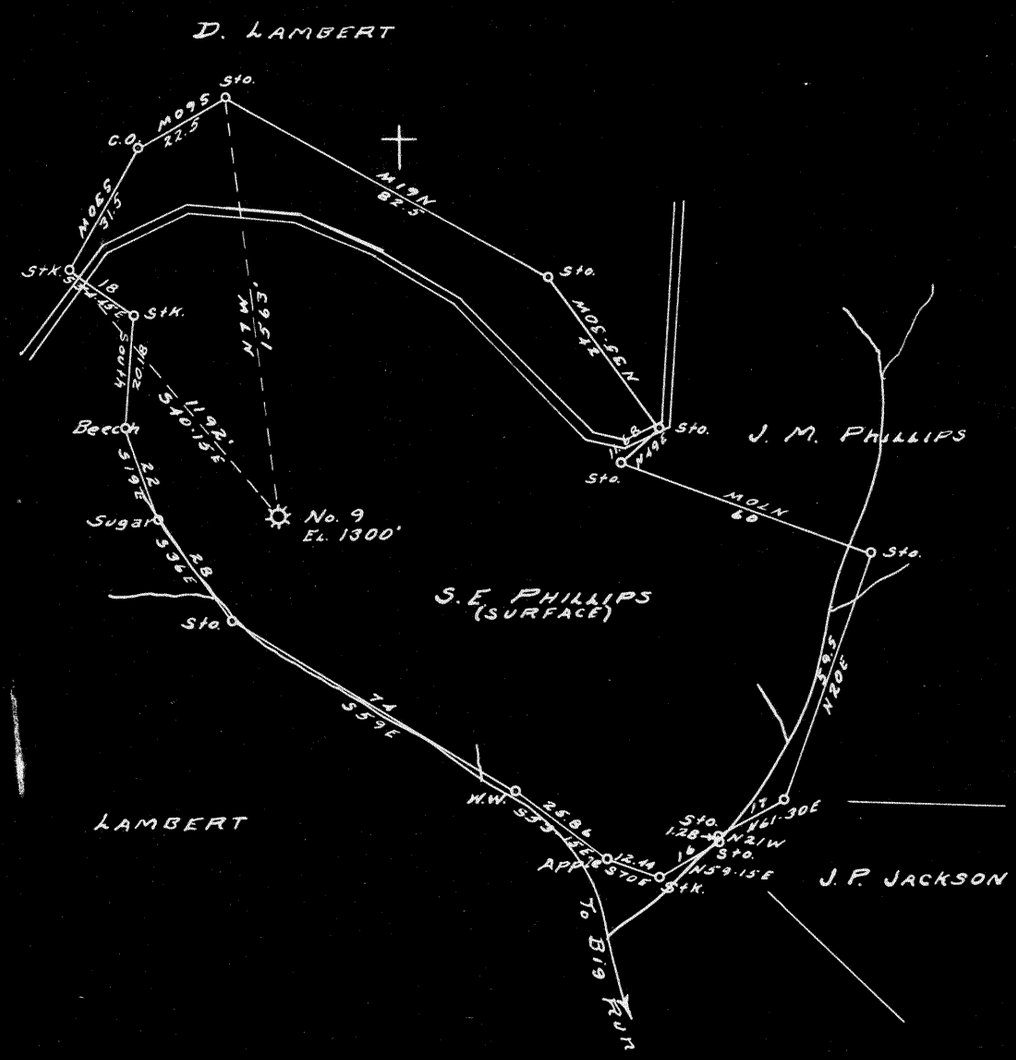

3.28 S
4.00 W

New Location ☐
Drill Deeper ☐
Abandonment ☒

Company CARNEGIE NATURAL GAS
Address PITTSBURGH, PA.
Farm F. M. BLAKE
Tract _____ Acres 82 Lease No. E 1117-71
Well (Farm) No. 7 Serial No. E 9
Elevation (Spirit Level) 1300'
Quadrangle LITTLETON S.E.
County WETZEL District CENTER
Engineer Glen H. Bury
Engineer's Registration No. 2011
File No. _____ Drawing No. _____
Date 1-21-49 Scale 1" = 40 Poles

"IMPERIAL" TRACING CLOTH
K & E CO., N. Y.

STATE OF WEST VIRGINIA
DEPARTMENT OF MINES
OIL AND GAS DIVISION
CHARLESTON

WELL LOCATION MAP

FILE NO. Wet-809-A

✚ Denotes location of well on United States Topographic Maps, scale 1 to 62,500, latitude and longitude lines being represented by border lines as shown.

— Denotes one inch spaces on border line of original tracing.

OG-10

1250

STATE OF WEST VIRGINIA
DEPARTMENT OF MINES
OIL AND GAS DIVISION

WELL RECORD

Permit No. Ab-809-A

WELL TO BE ABANDONED

Oil or Gas Well GAS (KIND)

Company CARNEGIE NATURAL GAS COMPANY
Address 1015 Frick Bldg., PITTSBURGH, PA.
Farm F. M. BLAKE Acres 82
Location (waters) BIG RUN
Well No. 2-E-9 Elev. 1300
District GRANT County WETZEL
The surface of tract is owned in fee by S. E. PHILLIPS,
Address FAIRMONT, W.VA.
Mineral rights are owned by HEIRS of F. M. BLAKE,
H.L. UTT, Atty-in-Fact, Address PINE GROVE, W.VA.
Drilling commenced 4-18-05
Drilling completed 6-22-05
Date Shot From To
With
Open Flow /10ths Water in Inch
/10ths Merc. in Inch
Volume Cu. Ft.
Rock Pressure lbs. hrs.
Oil bbls., 1st 24 hrs.
Fresh water feet feet
Salt water feet feet

Casing and Tubing	Used in Drilling	Left in Well	Packers
Size			
16			Kind of Packer
13			
10	400	None	Size of
8¼	1500	815	
6⅝	2230	2230	Depth set
5 3/16			
3			Perf. top
2			Perf. bottom
Liners Used			Perf. top
			Perf. bottom

CASING CEMENTED SIZE No. Ft. Date

COAL WAS ENCOUNTERED AT 1010 FEET INCHES
FEET INCHES FEET INCHES
FEET INCHES FEET INCHES

Formation	Color	Hard or Soft	Top	Bottom	Oil, Gas or Water	Depth Found	Remarks
Pittsburgh Coal			1010				
ig Injun Sand			2255		Gas	2270	
					Gas	2333-2343	
ordon Stray			3027	3049			
ordon Sand			3061	3079			
		TOTAL DEPTH		3085			

C

APR 1969 WEST VIRGINIA DEPARTMENT OF MINES

(Over) SEP 27 1949

Formation	Color	Hard or Soft	Top	Bottom	Oil, Gas or Water	Depth Found	Remarks

Date APRIL 26, 1949

APPROVED CARNEGIE NATURAL GAS COMPANY, Owner

By B. D. Anker
(Title) Land Agent.

2