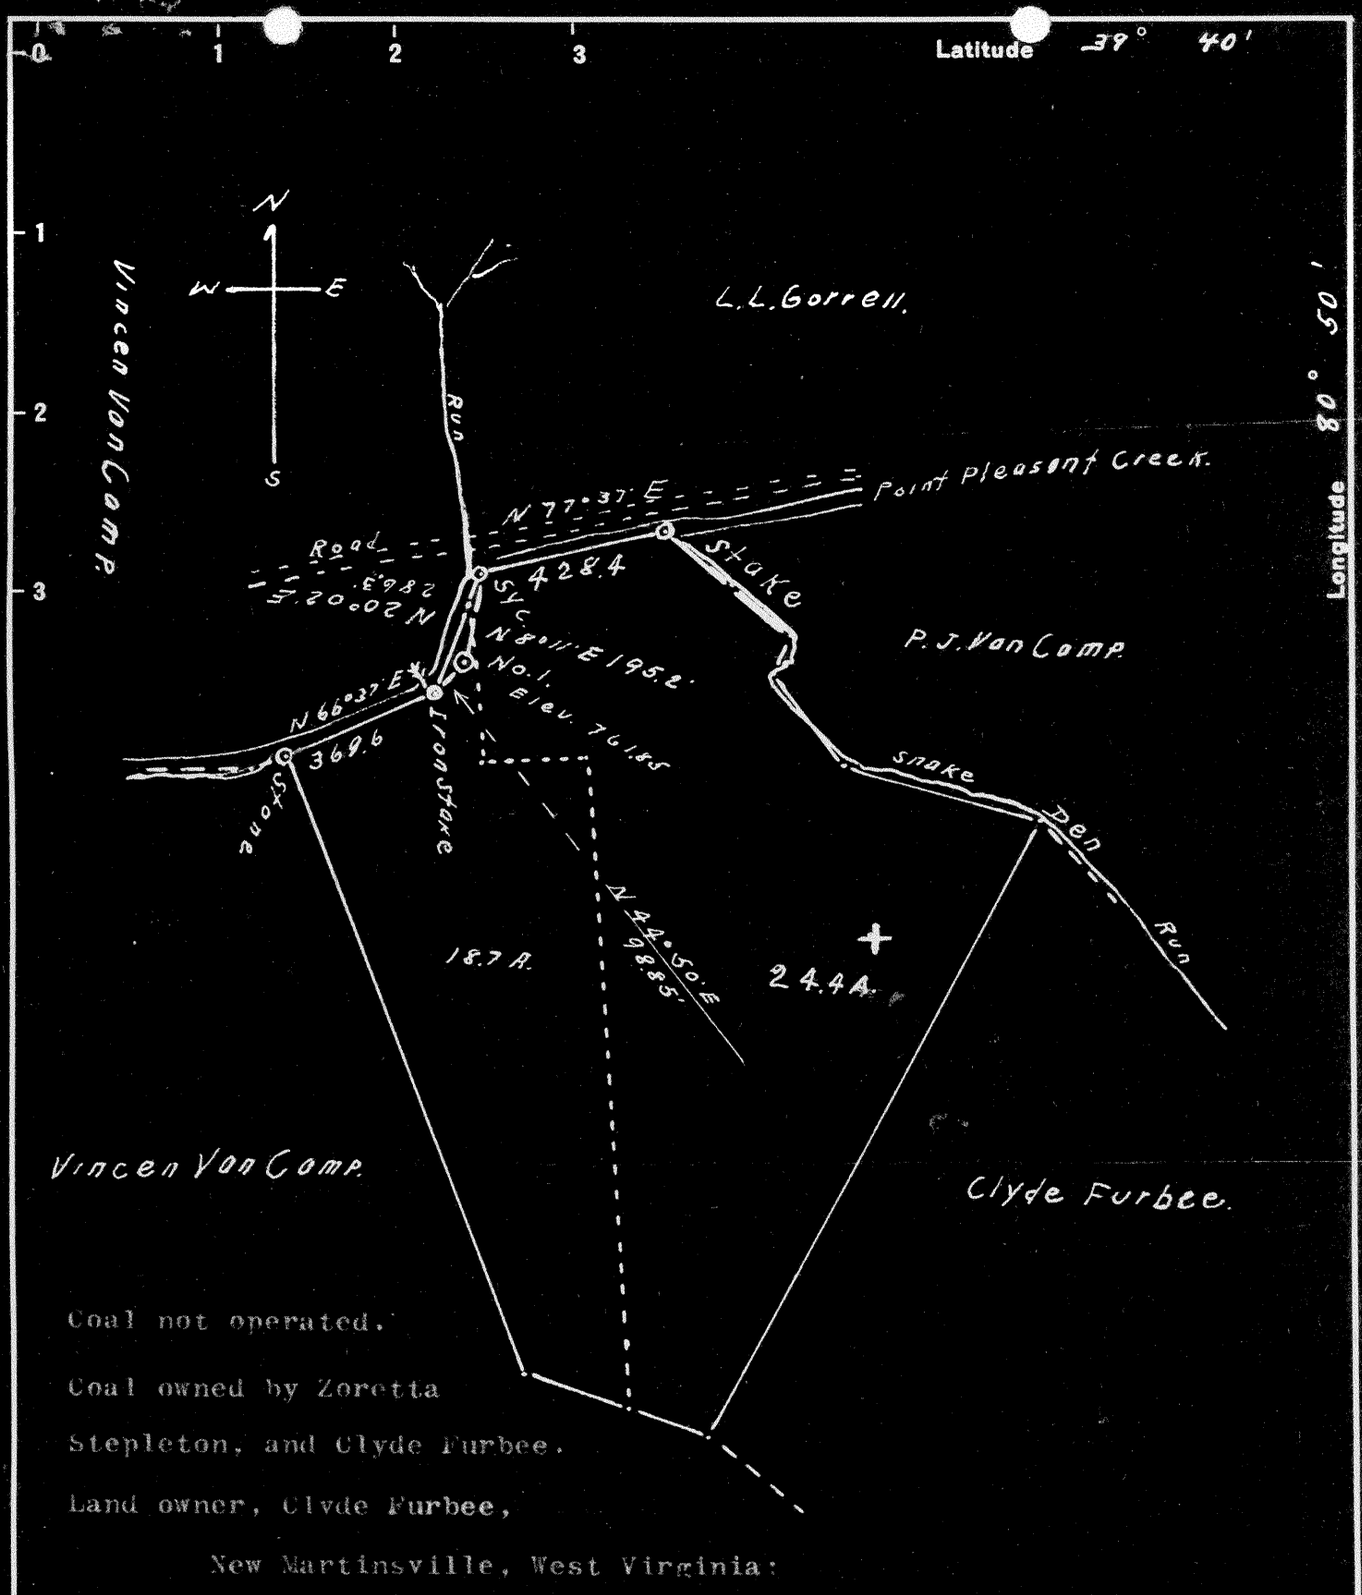


Coal not operated.

Coal owned by Zoretta Stepleton, and Clyde Furbee.

Land owner, Clyde Furbee,

New Martinsville, West Virginia:

S 5.14
W 2.67

New Location..☐
Drill Deeper.....☐
Abandonment.....☒

Company Melrose Oil and Gas Co:
Address Sistersville, West Virginia:
Farm Henry Fulmer,
Tract One Acres 43 Lease No.
Well (Farm) No. 1, Serial No.
Elevation (Spirit Level) 761.85 Feet,
Quadrangle New Martinsville,
County Wetzel District Magnolia,
Engineer J. M. Cochran.
Engineer's Registration No. Co: Surveyor,
File No. Drawing No.
Date 11 - 1 -1950 Scale 1" = 400:

STATE OF WEST VIRGINIA
DEPARTMENT OF MINES
OIL AND GAS DIVISION
CHARLESTON

# WELL LOCATION MAP

FILE NO. Wet-882-A

✚ Denotes location of well on United States Topographic Maps, scale 1 to 62,500, latitude and longitude lines being represented by border lines as shown.

— Denotes one inch spaces on border line of original tracing.

"IMPERIAL" TRACING CLOTH
K & E CO., N. Y.

OG-10

1330

STATE OF WEST VIRGINIA
DEPARTMENT OF MINES
OIL AND GAS DIVISION

# WELL RECORD

Ap 887-A

Permit No. _____

Oil or Gas Well Oil (KIND)

Company Melrose Oil & Gas Co.
Address Box 150 Sistersville, W. Va.
Farm Henry Fulmer Acres 43
Location (waters) _____
Well No. 1 Elev. 761.85
District Magnolia County Wetzel
The surface of tract is owned in fee by Clyde Furbee
Address New Martinsville, W.Va.
Mineral rights are owned by Melrose Oil & Gas Co.
Address Sistersville, W.Va.
Drilling commenced November 1922
Drilling completed December 1922
Date Shot _____ From _____ To _____
With _____
Open Flow /10ths Water in _____ Inch
/10ths Merc. in _____ Inch
Volume _____ Cu. Ft.
Rock Pressure _____ lbs. _____ hrs.
Oil _____ bbls., 1st 24 hrs.
Fresh water _____ feet _____ feet
Salt water _____ feet _____ feet

| Casing and Tubing | Used in Drilling | Left in Well | Packers |
|---|---|---|---|
| Size | | | |
| 16 | | | Kind of Packer |
| 13 | | | |
| 10 | | | Size of |
| 8¼ | 1200 | None | |
| 6⅝ | 1637 | 1637 | Depth set |
| 5 3/16 | | | |
| 3 | | | Perf. top |
| 2 | 1718 | 1718 | Perf. bottom |
| Liners Used | | | Perf. top |
| | | | Perf. bottom |

CASING CEMENTED _____ SIZE _____ No. Ft. _____ Date

COAL WAS ENCOUNTERED AT _____ FEET _____ INCHES
_____ FEET _____ INCHES _____ FEET _____ INCHES
_____ FEET _____ INCHES _____ FEET _____ INCHES

| Formation | Color | Hard or Soft | Top | Bottom | Oil, Gas or Water | Depth Found | Remarks |
|---|---|---|---|---|---|---|---|
| Keener | | | 1668 | 1718 | | | |

DEC 1950 WEST VIRGINIA DEPARTMENT OF MINES

(Over)

JUN 24 1951