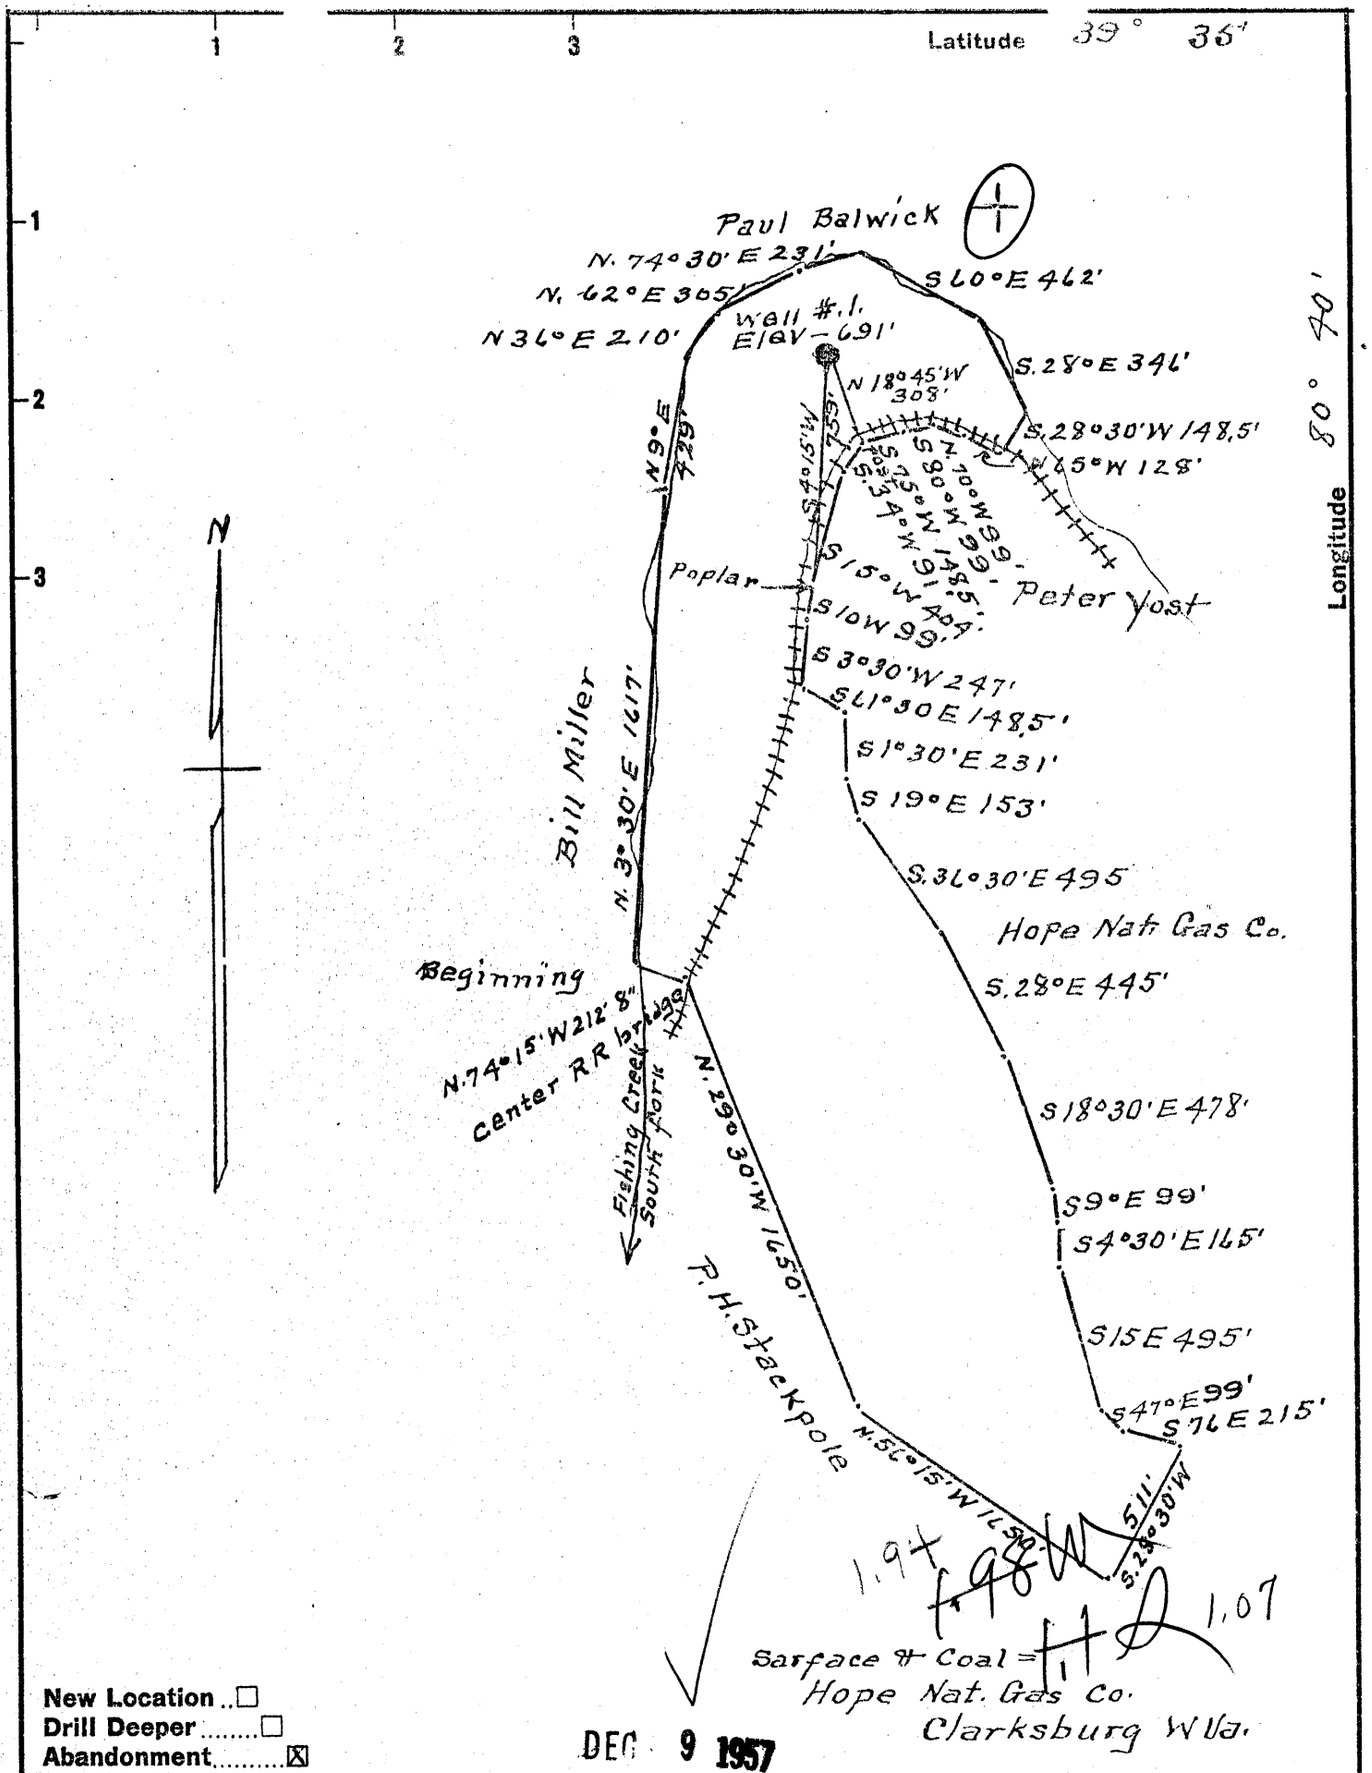

New Location ..☐
Drill Deeper .....☐
Abandonment.....☒

DEC 9 1957

Company A. M. Snider
Address Hundred W. Va.
Farm Ara Toy Long
Tract 1 Acres 83½ Lease No.
Well (Farm) No. 1 Serial No. 5881
Elevation (Spirit Level) 691'
Quadrangle Littleton
County Wetzel District Green
Engineer A. L. Headley
Engineer's Registration No. 2021
File No. Drawing No.
Date 7-18-57 Scale 1" = 600'

STATE OF WEST VIRGINIA
DEPARTMENT OF MINES
OIL AND GAS DIVISION
CHARLESTON

WELL LOCATION MAP

FILE NO. Wet-1075-A

+ Denotes location of well on United States Topographic Maps, scale 1 to 62,500, latitude and longitude lines being represented by border lines as shown.

— Denotes one inch spaces on border line of original tracing.

ARA TOY LONG No. 1 (5881) — A. M. SNIDER — WET-1075-A