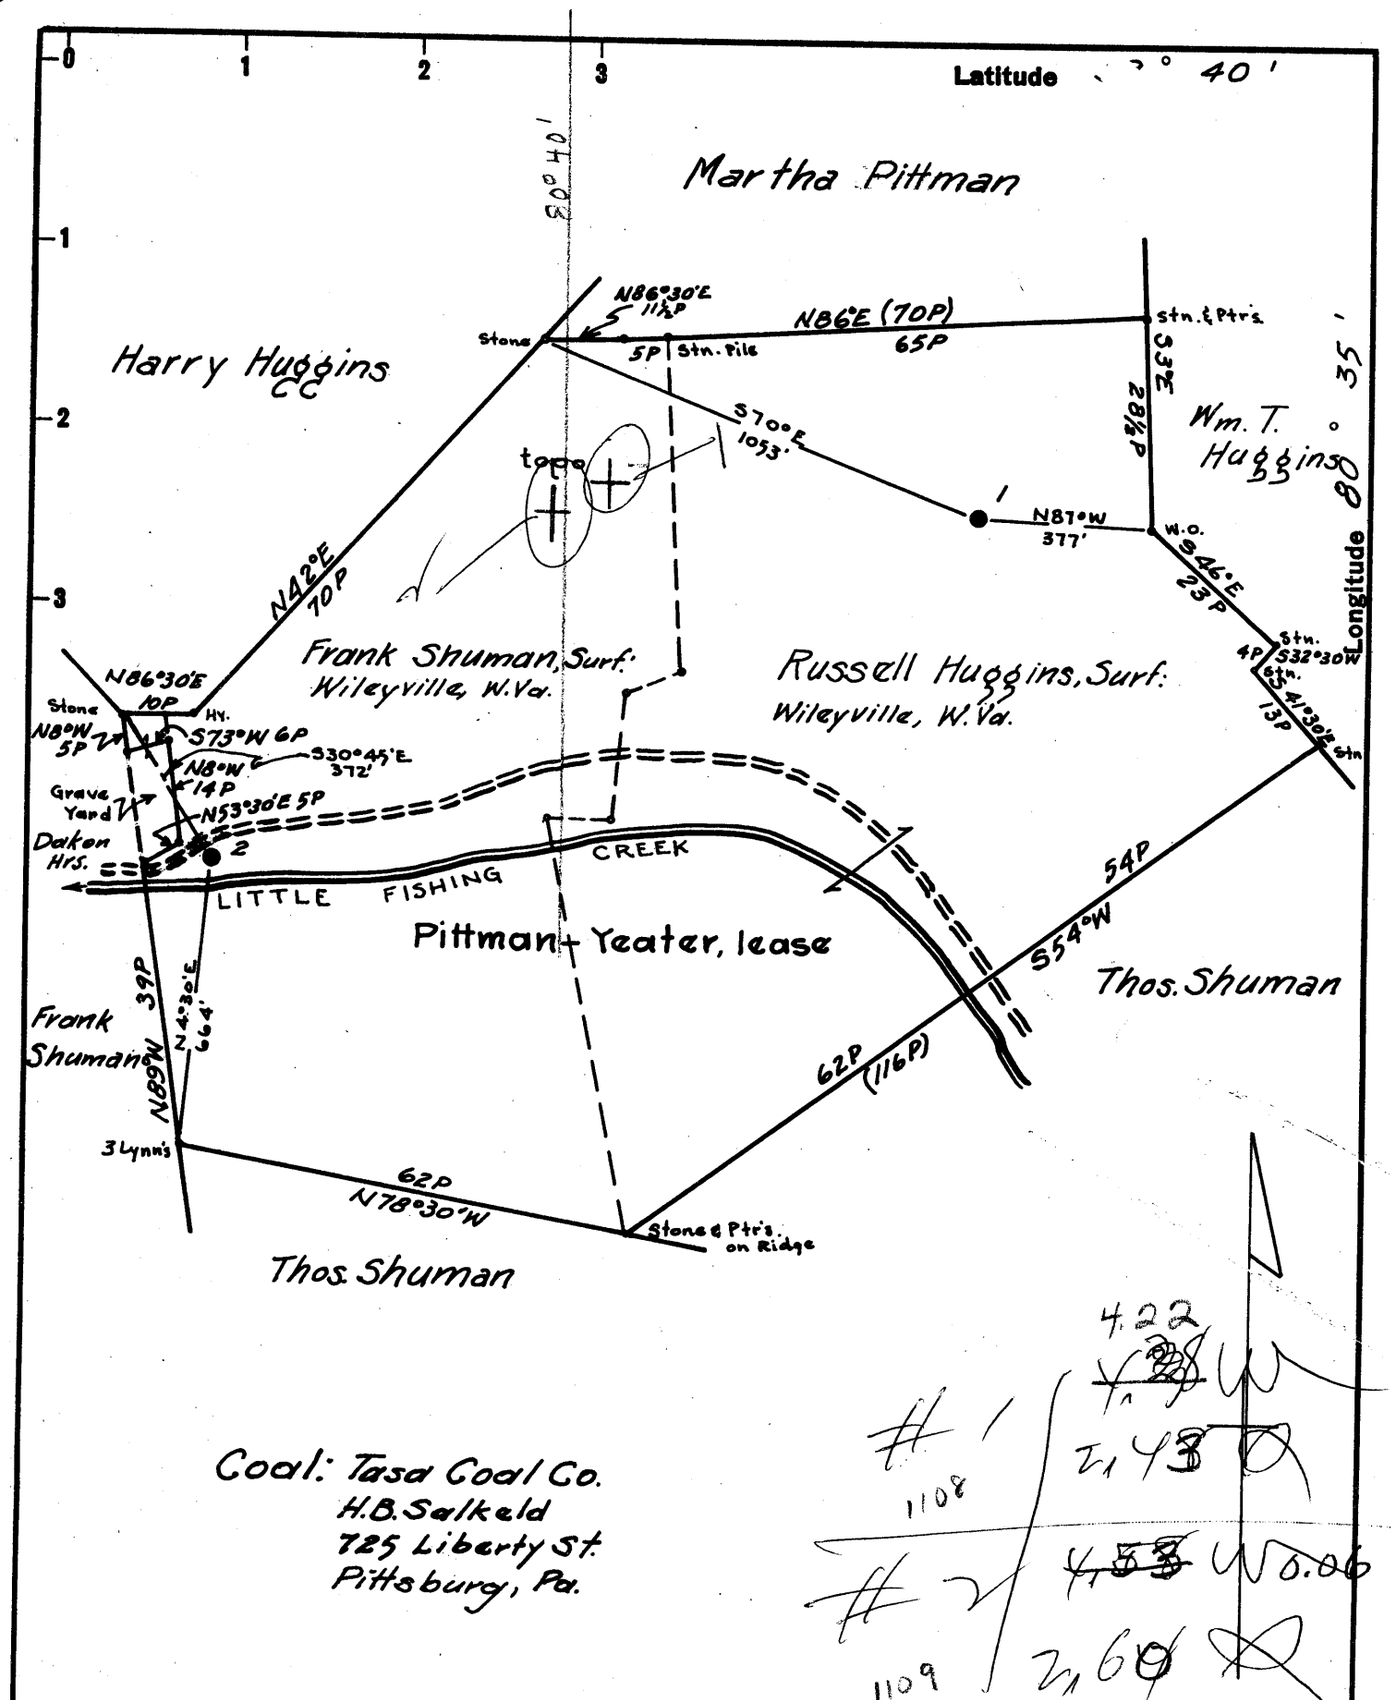

Coal: Tasa Coal Co.
H.B. Salkeld
725 Liberty St.
Pittsburg, Pa.

New Location ..☐
Drill Deeper.....☐
Abandonment.....☒

DEC 31 1959

MAP N78 N13 W2-3

Company South Penn Natural Gas Co.
Address Parkersburg, W.Va.
Farm Pittman - Yeater
Tract _____ Acres 100 Lease No. 38782 51986
Well (Farm) No. 1 & 2 Serial No. _____
Elevation (Spirit Level) (1) 1060.00' (2) 807.00' ft.
Quadrangle Littletone
County Wetzel District Center
Engineer A.C. Hilbert
Engineer's Registration No. 2534
File No. 541 Drawing No. _____
Date Sept. 24, 1959 Scale 1" = 400'

STATE OF WEST VIRGINIA
DEPARTMENT OF MINES
OIL AND GAS DIVISION
CHARLESTON

WELL LOCATION MAP

FILE NO. WET-1108-P#1 A
WET-1109-P#2 A

+ Denotes location of well on United States Topographic Maps, scale 1 to 62,500, latitude and longitude lines being represented by border lines as shown.

— Denotes one inch spaces on border line of original tracing.

VJBo

64120

PITTMAN - YEATER #S 1 & 2 — SOUTH PENN NG Co. — WET-1108-09-A