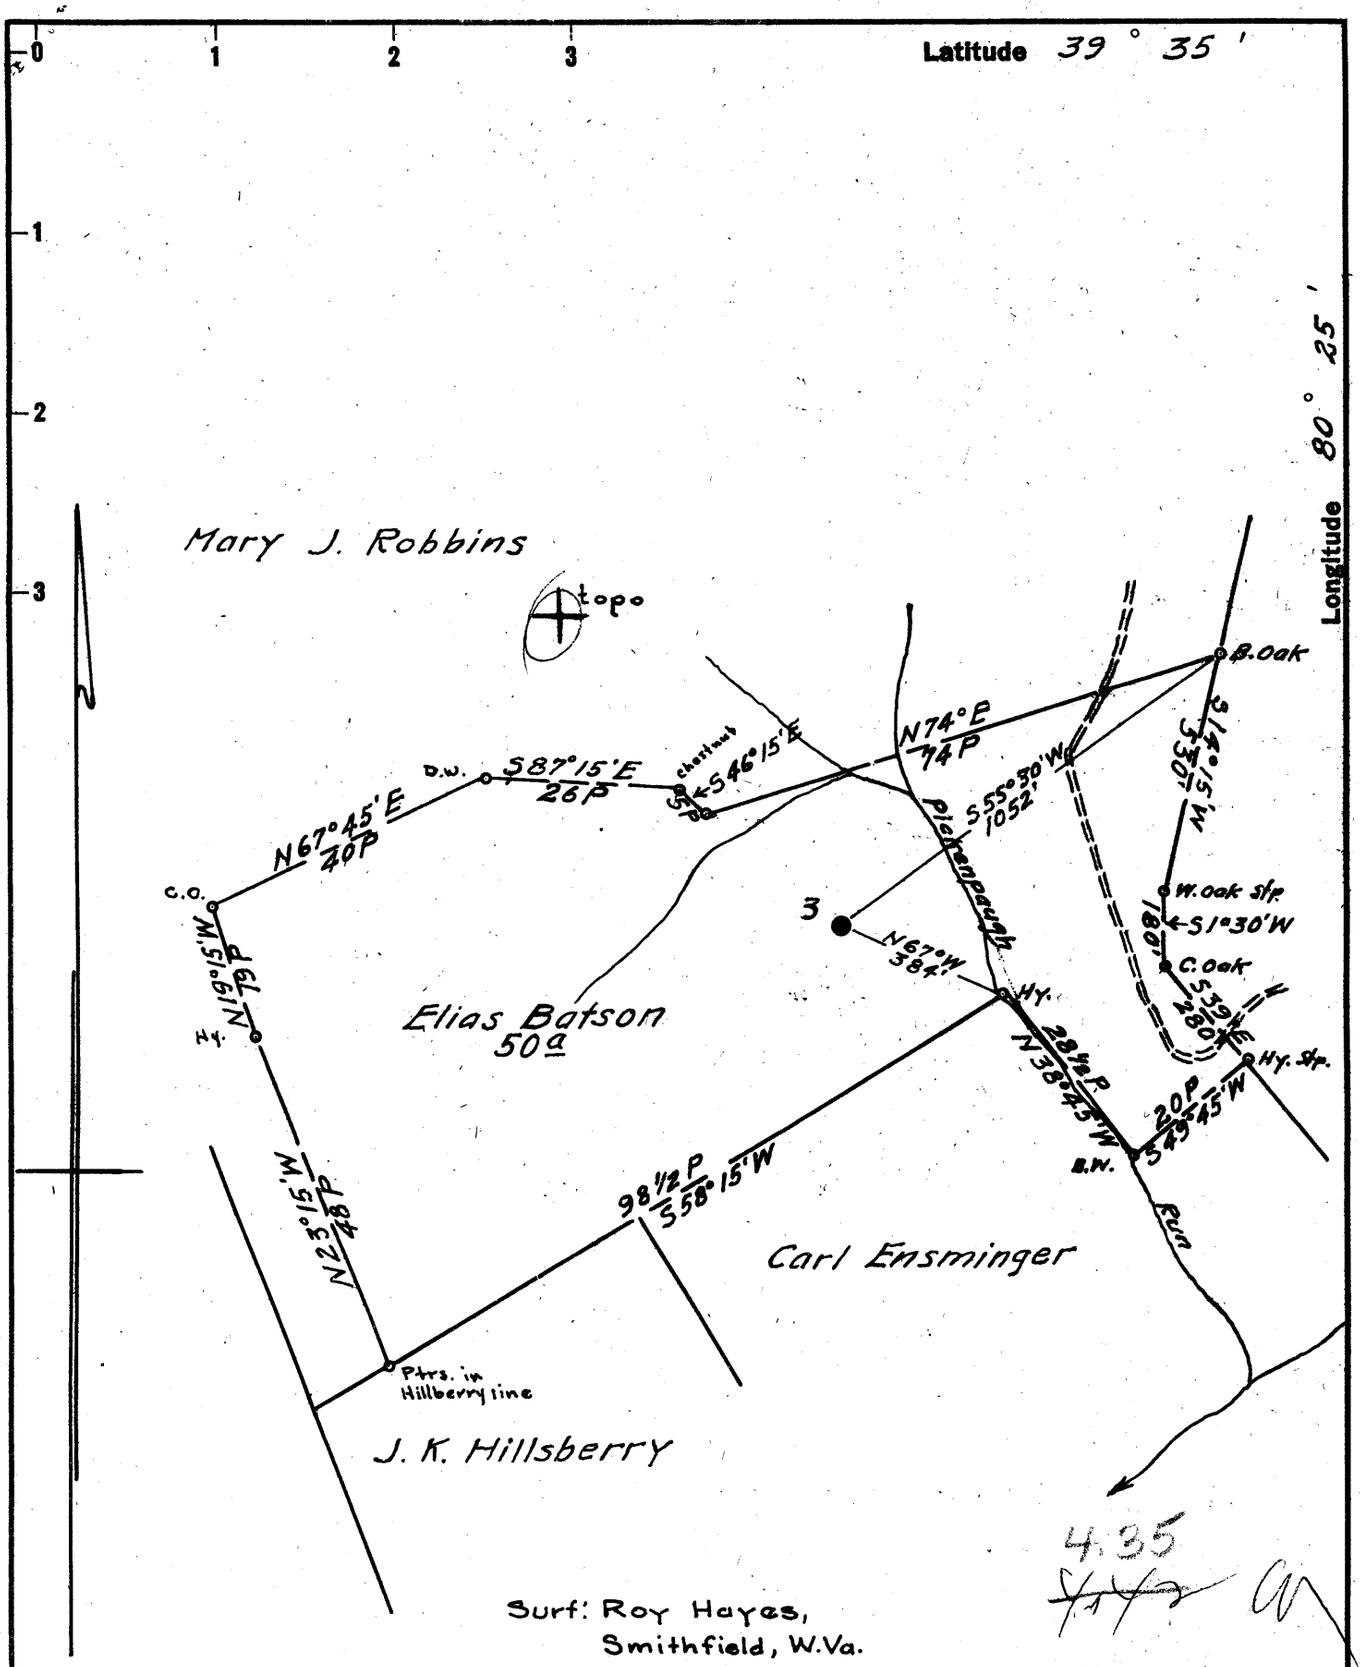

Company SOUTH PENN OIL CO.

Address PARKERSBURG, W.Va.

Farm ELIAS BATSON

Tract _____ Acres 54 Lease No. ~~15866-RG.~~ 15191

Well (Farm) No. 3 Serial No. _____

Elevation (Spirit Level) 1167.49 Floor

Quadrangle MANNINGTON

County WETZEL District GRANT

Engineer A. C. Hilbert

Engineer's Registration No. 2534

File No. 1040 Drawing No. _____

Date Sept. 20, 1960 Scale 1" = 400'

STATE OF WEST VIRGINIA
DEPARTMENT OF MINES
OIL AND GAS DIVISION
CHARLESTON

WELL LOCATION MAP

FILE NO. WET-1119-A

+ Denotes location of well on United States Topographic Maps, scale 1 to 62,500, latitude and longitude lines being represented by border lines as shown.

— Denotes one inch spaces on border line of original tracing.

64120

ELIAS BATSON No. 3 — SOUTH PENN OIL CO. — WET-1119-A