LATITUDE 39 ° 40 '

LONGITUDE 80 ° 40'

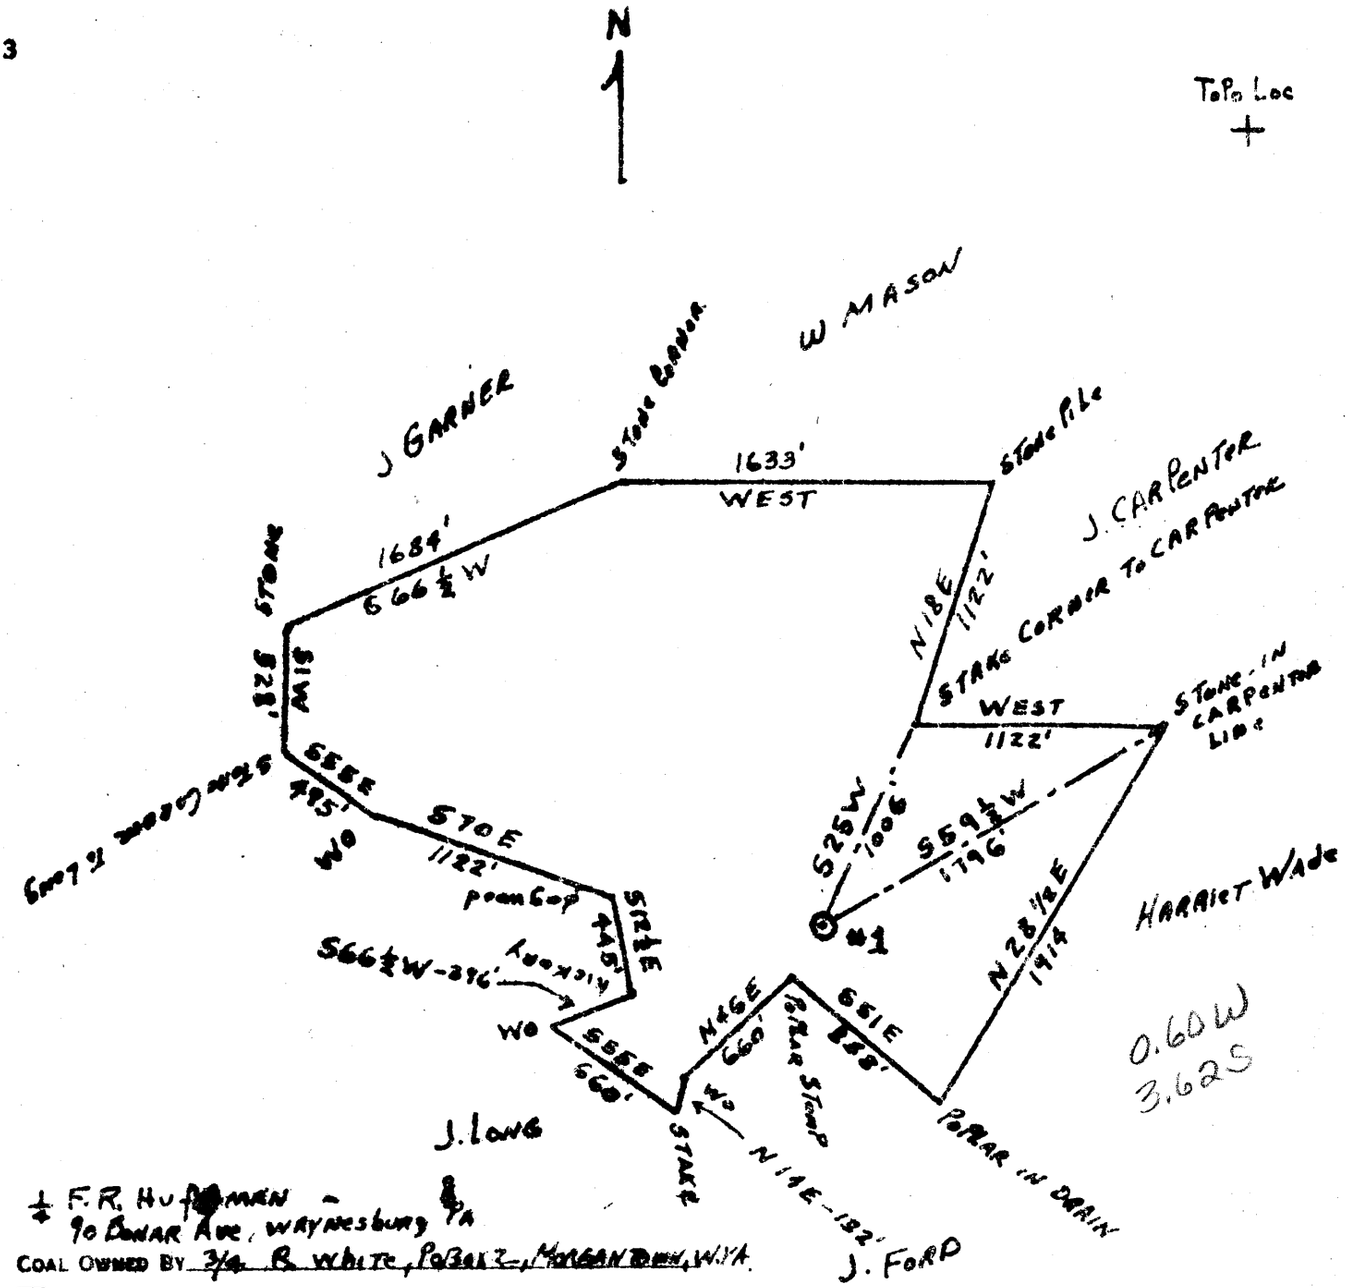

☐ NEW LOCATION
☐ RECONDITION
☐ DRILL DEEPER
☒ ABANDONMENT

"I, the undersigned, hereby certify that this map is correct to the best of my knowledge and belief and shows all the information required by paragraph 6 of the rules and regulations of the oil and gas section of the mining laws of West Virginia."

Minimum degree of accuracy is one part in 200

PA 8567E

Signed A. T. Robertson

COMPANY William Cassady
ADDRESS 4302 Whited Drive, Vienna, W VA
FARM Joseph Ruckman (Sadie Bear John)
MAP _____ ACRES 150 LEASE NO. _____
WELL (FARM) NO. #1 SERIAL NO. _____
ELEVATION (SPIRIT LEVEL) 1103
QUADRANGLE Littleton-WC
COUNTY WETZEL DISTRICT GREEN
POINT OF PROVEN ELEVATION Bill 1410 - Bug Grove Topo
FILE NO. FOK13 PG 56 DRAWING NO. _____
DATE 5-12-65 SCALE 1" = 800'

STATE OF WEST VIRGINIA
DEPARTMENT OF MINES
OIL AND GAS DIVISION
CHARLESTON

WELL LOCATION MAP

FILE NO. WET-1182-A

✚ DENOTES LOCATION OF WELL ON UNITED STATES TOPOGRAPHIC MAPS, SCALE 1 TO 62,500, LATITUDE AND LONGITUDE LINES BEING REPRESENTED BY BORDER LINES AS SHOWN.

— DENOTES ONE INCH SPACES ON BORDER LINE OF ORIGINAL TRACING.