39° 32' 30"

Latitude

80°37'30"

Longitude

1.88s
.46w

Topo Location

7.5' Loc. _____ 15' Loc. _____
(calc.)

Company Quaker State Oil Refg Corp.

Farm John Mills #113

15' Quad _____
(sec.)

7.5' Quad Pine Grove

District Grant

WELL LOCATION PLAT

County 103 Permit 50002

Latitude 39 ° 35 '

Longitude 80 ° 35 '

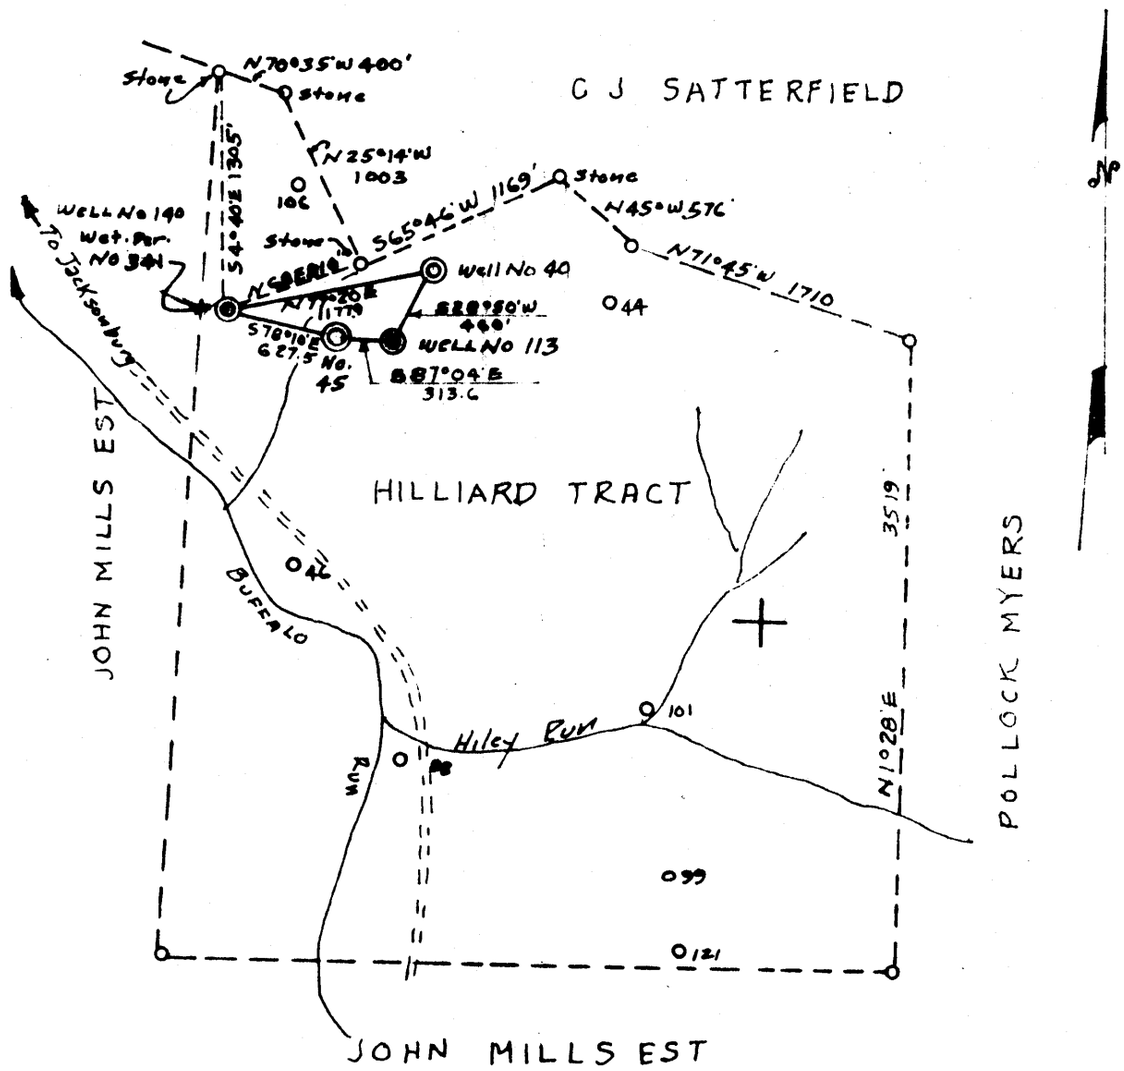

MINIMUM ERROR OF CLOSURE 1' in 200

SOURCE OF ELEVATION USGS BM No Q138 Above Mouth of Seese Run on North Side of Road Elev. 777.0

New Location ☐
Drill Deeper ☐
Abandonment ☐
FRACTURE ☒

"I, THE UNDERSIGNED, HEREBY CERTIFY THAT THIS MAP IS CORRECT TO THE BEST OF MY KNOWLEDGE AND BELIEF AND SHOWS ALL THE INFORMATION REQUIRED BY PARAGRAPH 6 OF THE RULES AND REGULATIONS OF THE OIL AND GAS SECTION OF THE MINING LAWS OF WEST VIRGINIA."

Company Quaker State Oil Refg. Corp.
Address P.O. Box 1327 Parkersburg, W. Va.
Farm John Mills
Tract _____ Acres 5200 Lease No. _____
Well (Farm) No. 113 Serial No. _____
Elevation (Spirit Level) 1067.0
Quadrangle LITTLETON -SC
County WETZEL District GRANT
Engineer J. H. Johnston
Engineer's Registration No. 2492
File No. _____ Drawing No. _____
Date Jan 13, 1966 Scale 1" = 1000'

STATE OF WEST VIRGINIA
DEPARTMENT OF MINES
OIL AND GAS DIVISION
CHARLESTON

WELL LOCATION MAP

FILE NO. WET-2-FRAC

+ Denotes location of well on United States Topographic Maps, scale 1 to 62,500, latitude and longitude lines being represented by border lines as shown.

— Denotes one inch spaces on border line of original tracing.

Stephens Blueprint and Supply Company · Parkersburg, W. Virginia