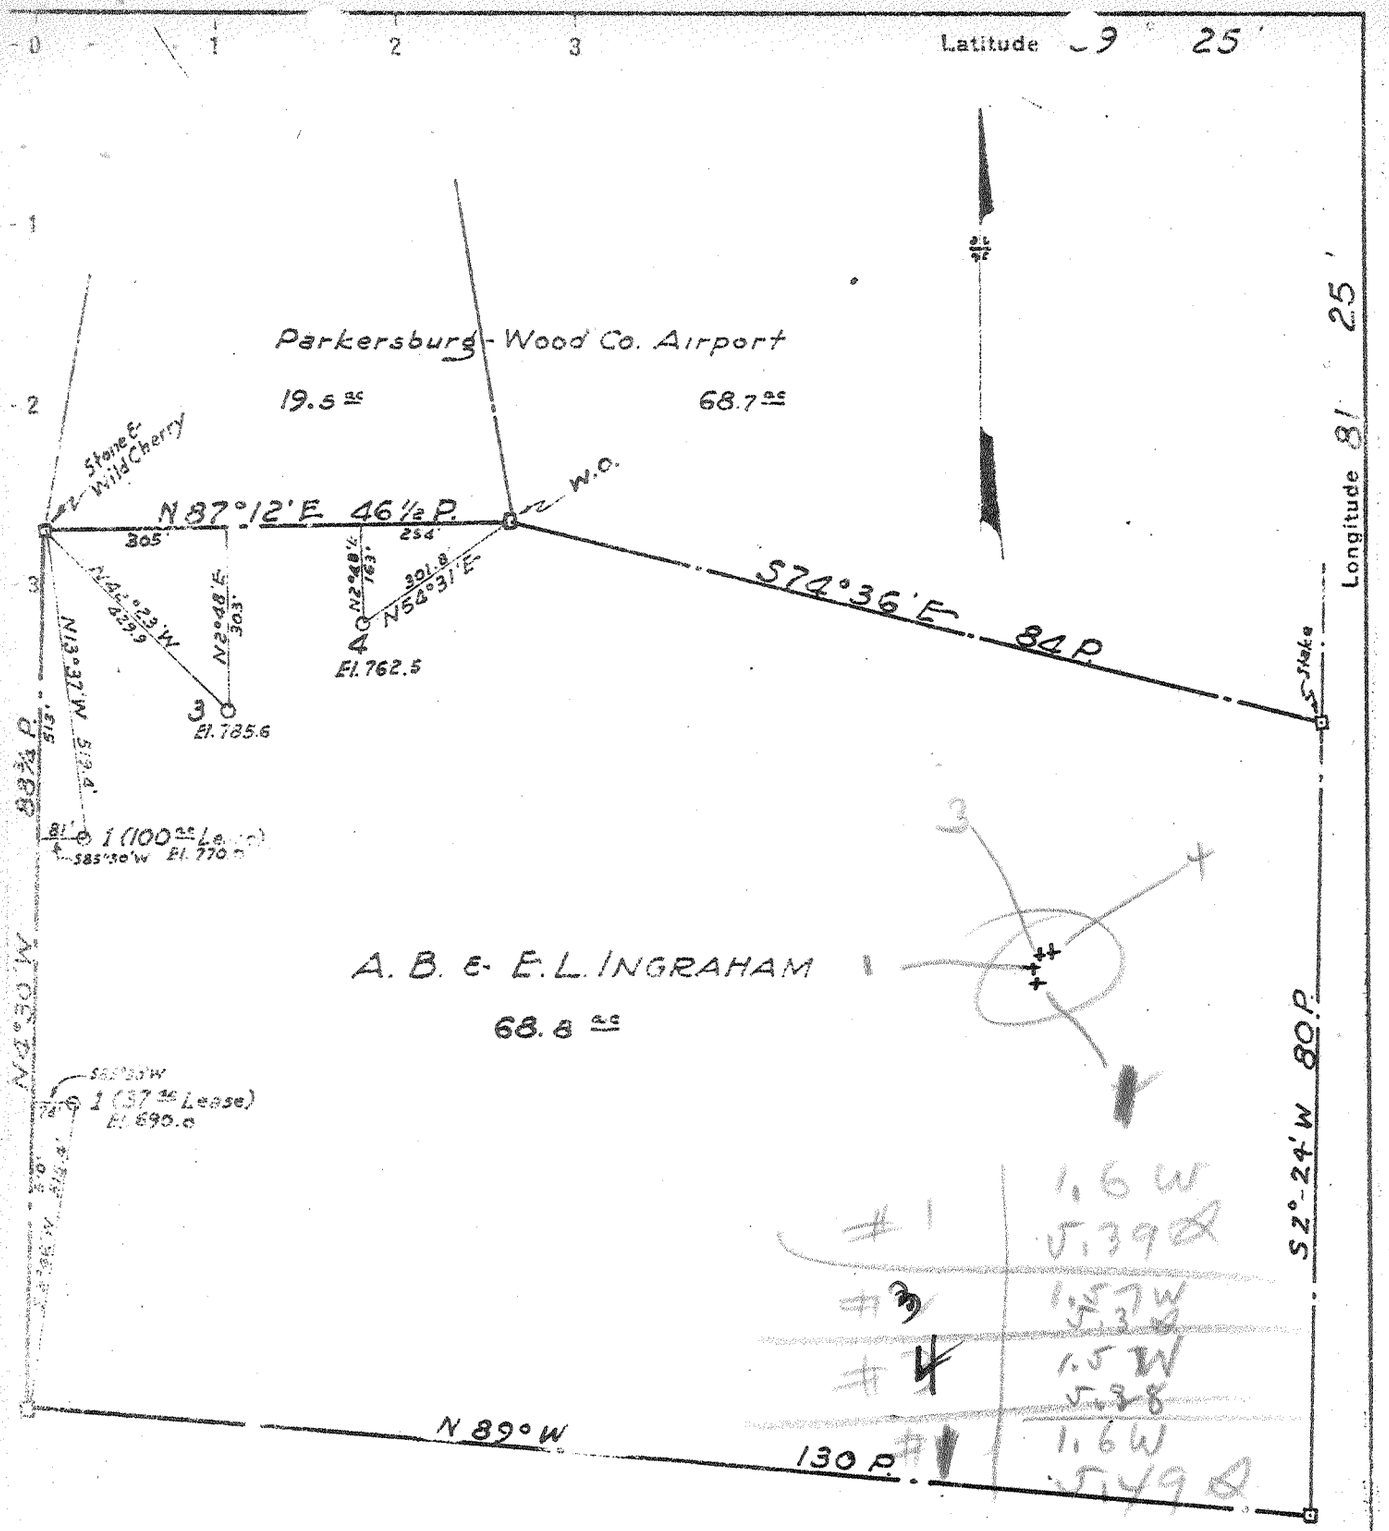

Woo - 233 - #4
Woo - 234 - #3
Woo - 235 - #1
ELEV - 770'
Woo - 236 - #1
ELEV - 690'

New Location ✓
Drill Deeper ✓
Abandonment ✓ X

MAY 26 1944

Company B. H. Gorrell & E. S. Briggs
Address Williamstown, W. Va.
Farm Parkersburg-Wood Co. Airport
Tract ____ Acres 68.8 Lease No. ____
Well (Farm) No. 1, 1, 3 & 4 Serial No. ____
Elevation (Spirit Level) Various
Quadrangle Marietta, Ohio
County Wood, W.Va. District Williams
Engineer Leland G. Merrill
Engineer's Registration No. ____
File No. ____ Drawing No. ____
Date Aug. 26, '43 Scale 1" = 200'

STATE OF WEST VIRGINIA
DEPARTMENT OF MINES
OIL AND GAS DIVISION
CHARLESTON

WELL LOCATION MAP

FILE NO. See Below
Woo — 233-4-5-6-A

+ Denotes location of well on United States Topographic Maps, scale 1 to 62,500, latitude and longitude lines being represented by border lines as shown.

— Denotes one inch spaces on border line of original tracing.

PARKERSBURG, WOOD CO., AIRPORT Nos. 1, 1, 3, 4 — B. H. GORRELL & E. S. BRIGGS — Woo-233-A-5-6-A

OG-10

201

STATE OF WEST VIRGINIA
DEPARTMENT OF MINES
OIL AND GAS DIVISION

WELL RECORD

Permit No. ~~14~~ 235-A

Oil or Gas Well Oil (KIND)

Company B. H. Govell & E. S. Briggs
Address Williamstown W.Va.
Farm Parkersburg-Wood Acres 68.1
~~Location (waters)~~ Co airport
Well No. 1 Elev. Various 770
District Williams County Wood
The surface of tract is owned in fee by Parkersburg Wood Co airport Address Parkersburg W.Va.
Mineral rights are owned by B. H. Govell & E. S. Briggs Address Williamstown
Drilling commenced No record W.Va.
Drilling completed " "
Date Shot — From — To
With
Open Flow /10ths Water in Inch
/10ths Merc. in Inch
Volume Cu. Ft.
Rock Pressure lbs. hrs.
Oil No record bbls., 1st 24 hrs.
Fresh water feet feet
Salt water feet feet

Casing and Tubing	Used in Drilling	Left in Well	Packers
Size			
16			Kind of Packer
13			
10			Size of
8¼	150	150	
6⅝ 1/4	840	840	Depth set
5 3/16			
3			Perf. top
2		855	Perf. bottom
Liners Used			Perf. top
			Perf. bottom

CASING CEMENTED SIZE No. Ft. Date

COAL WAS ENCOUNTERED AT FEET INCHES
FEET INCHES FEET INCHES
FEET INCHES FEET INCHES

Formation	Color	Hard or Soft	Top	Bottom	Oil, Gas or Water	Depth Found	Remarks
1-St Cow Run Sand	Light	Soft	845	855	Oil	850	

MAY 1944 WEST VIRGINIA DEPARTMENT OF MINES

(Over)

JUN - 9 1944

Formation	Color	Hard or Soft	Top	Bottom	Oil, Gas or Water	Depth Found	Remarks

Date May - 1 - 51, 1944

APPROVED B. H. Gorsuch & E. S. Briggs Owner

By E. S. Briggs Mgr
(Title)

2